

WALTHALL
B 21
9-70

MISSISSIPPI
BOARD OF WATER COMMISSIONERS
416 North State Street
Jackson, Mississippi 39201

CODED

WATER WELL DRILLERS LOG

SEPT 1970 E. B. SHERRARD WALTHALL
date well completed firm name county well located

LANDOWNER:
WAYLAND SUMMERS
Rt. 1 - Kokomo, Miss.
(mailing address)

description of formations encountered	from	to
BED SAND & CLAY GRAVEL	0	15
GRAY CLAY & SAND STREAKS	15	70
SAND & GRAVEL	70	106

WELL LOCATION:
sec. 34 T. 4 N. R. 11 E.
S W
12 miles NNE of TYLERTOWN
(distance) (direction) (nearest town)

WELL PURPOSE:
(home) Irrigation, municipal, industrial

- WELL COMPLETION DATA:
- (1) diameter (inches) 2"
 - (2) total depth (feet) 106
 - (3) static water level (feet) 78 ^{below}/_{above} top of ground.
 - (4) casing PL, 103' (material) (depth)
2" if telescope see back. (size)
 - (5) screen 3' (length) (depth to top)
2" S.S. (size) (material)
 - (6) pump 1 (HP) 7 (yield gpm)
E (type power)
 - (7) electric log (yes or no)

CODED

(organization running log)

(8) how well bottom plugged BWV


OCT 19 1970

MISS. Bd. OF
WATER COMM.

DRILLERS REMARKS:

If well telescopes please
sketch and show depths.

GROUND LEVEL

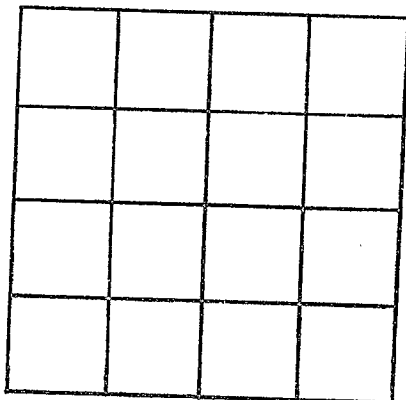

SECTION _____

Please indicate well location X.

ADDITIONAL INFORMATION

If more than one screen,
show locations of each on sketch.