

WALTHALL
B22
11-11-70
11-11-

MISSISSIPPI
BOARD OF WATER COMMISSIONERS
416 North State Street
Jackson, Mississippi 39201

CODED

WATER WELL DRILLERS LOG

11-11-70 1970 Fitzgerald & Co Walthall
date well completed firm name county well located

LANDOWNER:
Bobby Crawford
R.R. Tylertown, Miss
(mailing address)

description of formations encountered	from	to
Red clay	0	20
Red sand	20	80
lime sand + gravel	80	93

WELL LOCATION:
sec. 33 T 4 N R. 11 E
S W
8 miles N of Tylertown
(distance) (direction) (nearest town)

WELL PURPOSE: Home
(home, irrigation, municipal, industrial)

- WELL COMPLETION DATA:
- (1) diameter (inches) 4
 - (2) total depth (feet) 93
 - (3) static water level (feet) 80 below above top of ground.
 - (4) casing duct, 87,
(material) (depth)
4 if telescope see back.
(size)
 - (5) screen 6, 87
(length) (depth to top)
f, plaster
(size) (material)
 - (6) pump 1, 6
(HP) (yield gpm)
Ele
(type power)
 - (7) electric log no
(yes or no)
 - (organization running log)
 - (8) how well bottom plugged wood pie

CODED


NOV 16 1970

MISS. Bd. of
WATER COMMISSIONERS

DRILLERS REMARKS:

If well telescopes please sketch and show depths.

GROUND LEVEL

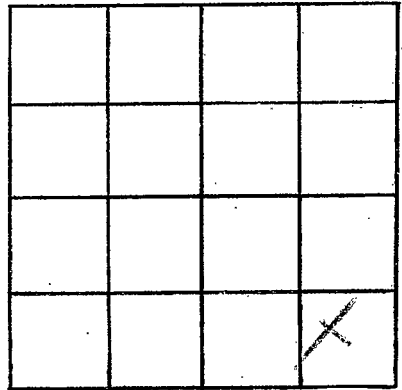

SECTION 32

Please indicate well location X.

ADDITIONAL INFORMATION

If more than one screen,
show locations of each on sketch.