

WALTHALL

B 23

10-26-70

MISSISSIPPI BOARD OF WATER COMMISSIONERS
416 North State Street
Jackson, Mississippi 39201

CODED

WATER WELL DRILLERS LOG

Oct 26 1970 Chester Keener Walthall
date well completed firm name county well located

LANDOWNER: Marys Creek Baptist Church
RD - Tylertown -
(mailing address)

description of formations encountered	from	to
clay	0	15
sand	15	30
Sand & gravel	30	55
chalk	55	58
Sand & gravel	58	69

WELL LOCATION:
sec. 27 T. 4 N. R. 11 E.
11 miles NNE of Tylertown
(distance) (direction) (nearest town)

WELL PURPOSE: church
(home, irrigation, municipal, industrial)

- WELL COMPLETION DATA:
- (1) diameter (inches) 4
 - (2) total depth (feet) 69
 - (3) static water level (feet) 37 below top of ground.
 - (4) casing plastic Ballou
(material) (depth)
 - (size) if telescope see back.
 - (5) screen 6' (length) 63' (depth to top)
4" (size) plastic (material)
 - (6) pump 1/2 Sub (HP) 15 (yield gpm)
Electric (type power)
 - (7) electric log no (yes or no)

CODED

(organization running log)


(8) how well bottom plugged wooden plug

DRILLERS REMARKS: old well capped in

FEB 5 1971

If well telescopes please sketch and show depths.

GROUND LEVEL

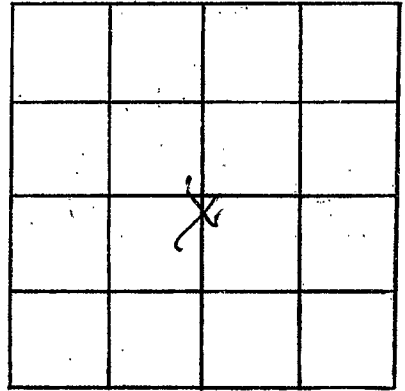

SECTION 27

Please indicate well location X.

ADDITIONAL INFORMATION

If more than one screen, show locations of each on sketch.