

WALTHALL
B 25
6-23-71

MISSISSIPPI
BOARD OF WATER COMMISSIONERS
416 North State Street
Jackson, Mississippi 39201

CODED

WATER WELL DRILLERS LOG

6-23 1971 Fitzgerald & Co Walthall
date well completed firm name county well located

LANDOWNER:

Neal Ward

description of formations encountered

from

to

R.R. Tylton, mem.
(mailing address)

Red Clay 0 20
Red sand 20 80
Coarse sand & gravel 80 106

WELL LOCATION:

sec 34 T 4N S R 11E W
6 miles East of Salem
(distance) (direction) (nearest town)

WELL PURPOSE:

Home
(home, irrigation, municipal, industrial)

WELL COMPLETION DATA:

- (1) diameter (inches) 4
- (2) total depth (feet) 106
- (3) static water level (feet) 70 below top of ground.
- (4) casing plastic, 98,
(material) (depth)
4 if telescope see back.
(size)
- (5) screen 8, 98
(length) (depth to top)
4, plastic
(size) (material)
- (6) pump 1/2, 10
(HP) (yield gpm)
Clear
(type power)
- (7) electric log no
(yes or no)
(organization running log)
- (8) how well bottom plugged Good per

CODED


III 22 1971

DRILLERS REMARKS:

MISS. BD. OF
WATER COMMISSIONERS

If well telescopes please sketch and show depths.

GROUND LEVEL

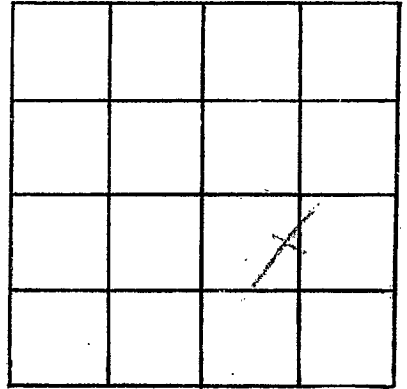

SECTION 34

Please indicate well location X.

ADDITIONAL INFORMATION

If more than one screen,
show locations of each on sketch.