

WALTHALL
B-26
8-27-71

MISSISSIPPI
BOARD OF WATER COMMISSIONERS
416 North State Street
Jackson, Mississippi 39201

WATER WELL DRILLERS LOG

CODED

8-27 1971
date well completed

F. J. Goodwell
firm name

county well located

LANDOWNER:	description of formations encountered	from	to
Olis E. Hurrey RR Daymen (mailing address)	Red Clay Red sand Coarse sand & gravel	0 20 40	20 40 108
WELL LOCATION: sec. 9 T 4 N R 11 E 2 miles E of Portville (distance) (direction) (nearest town)			
WELL PURPOSE: (home, irrigation, municipal, industrial) Home			
WELL COMPLETION DATA:			
(1) diameter (inches) 4			
(2) total depth (feet) 108			
(3) static water level (feet) 60 below top of ground.			
(4) casing <u>plastic</u> (material), <u>100</u> (depth)			
<u>4</u> (size) if telescope see back.			
(5) screen <u>8</u> (length), <u>100</u> (depth to top)			
<u>4</u> (size), <u>plastic</u> (material)			
(6) pump <u>1/2</u> (HP), <u>10</u> (yield gpm)			
<u>Elc</u> (type power)			
(7) electric log <u>no</u> (yes or no)			
(organization running log)			
(8) how well bottom plugged <u>completely</u>			
DRILLERS REMARKS:			


CODED

SEP 15 1971

MISS. BD. OF
WATER COMM.

If well telescopes please sketch and show depths.

GROUND LEVEL

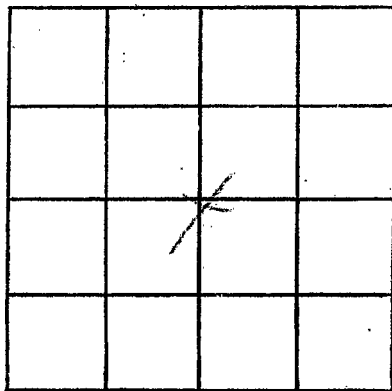

SECTION 9

Please indicate well location X.

ADDITIONAL INFORMATION

If more than one screen,
show locations of each on sketch.