

WALTHALL  
B 28  
10-4-71

MISSISSIPPI  
BOARD OF WATER COMMISSIONERS  
416 North State Street  
Jackson, Mississippi 39201

DEC 28 1971

WATER WELL DRILLERS LOG

**CODED**

set 4 1971 *Chet Reese* *Walthall*  
date well completed firm name county well located

LANDOWNER:

*Charles*

*Harriet -*  
*At 3 Jones -*  
(mailing address)

description of formations encountered

from to

clay	0	5
sand	5	60
chalk gravel	60	80
sand & gravel	80	94

WELL LOCATION:

sec. 9 T 4 N R 11 E  
1 miles E Spartanburg  
(distance) (direction) (nearest town)

WELL PURPOSE: *farm*  
(home, irrigation, municipal, industrial)

WELL COMPLETION DATA:

- (1) diameter (inches) 4"
- (2) total depth (feet) 94
- (3) static water level (feet) 55 below above top of ground.
- (4) casing Plast Bottom  
(material) (depth)

**CODED**

if telescope see back.  
(size)

- (5) screen 6' 88'  
(length) (depth to top)
- 1/4" Plast  
(size) (material)

- (6) pump 2 1/2 HP 2000 gpm  
(HP) (yield gpm)

(type power)

- (7) electric log NO  
(yes or no)

(organization running log)


- (8) how well bottom plugged wooden plug

DRILLERS REMARKS:

*old well bad.*

If well telescopes please sketch and show depths.

GROUND LEVEL

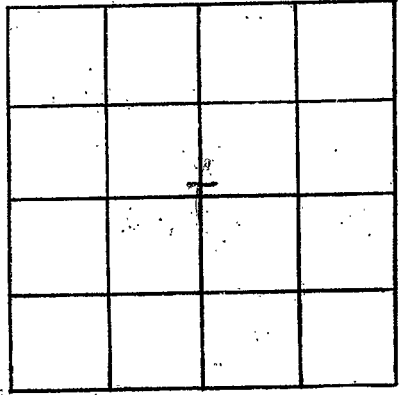

SECTION 9

Please indicate well location X.

ADDITIONAL INFORMATION

If more than one screen, show locations of each on sketch.