

WALTHALL  
B 29  
10-71

MISSISSIPPI  
BOARD OF WATER COMMISSIONERS  
416 North State Street  
Jackson, Mississippi 39201

WATER WELL DRILLERS LOG

OCT. 1971  
date well completed

E. B. SHERRARD  
firm name

LODGED  
county well located

LANDOWNER:

ACEY JENKINS  
JAYESS, MISS.  
(mailing address)

description of formations encountered

description of formations encountered	from	to
RED CLAY + SANDY CLAY	0	10'
GRAVEL MIXTURE	10'	75'
VERY COARSE SAND	75'	89'

WELL LOCATION:

sec. 18 T 4 N R 11 E  
12 1/2 miles N of Jayess  
(distance) (direction) (nearest town)

WELL PURPOSE:

(home, irrigation, municipal, industrial)

WELL COMPLETION DATA:

- diameter (inches) 2"
- total depth (feet) 89
- static water level (feet) 50 below top of ground.
- casing PL. 83 (material) (depth)  
2" (size) if telescope see back.
- screen 5' (length) (depth to top)  
2" (size) PL. (material)
- pump 3/4 (HP) 8 (yield gpm)  
E (type power)
- electric log (yes or no)
- (organization running log)
- how well bottom plugged Blind

CODED

CODED


FEB - 2 1972

DRILLERS REMARKS:

MISS. BD. OF  
WATER COMMISSIONERS

If well telescopes please sketch and show depths.

GROUND LEVEL

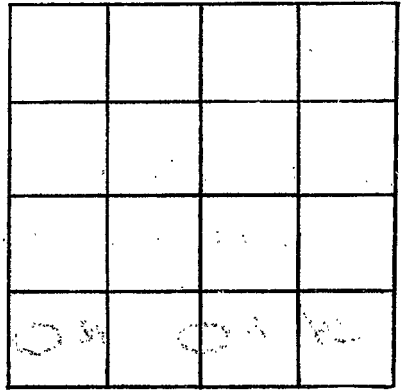

SECTION \_\_\_\_\_

Please indicate well location X.

ADDITIONAL INFORMATION

If more than one screen,  
show locations of each on sketch.