

WALTHALL

B30

4-3-72

MISSISSIPPI BOARD OF WATER COMMISSIONERS  
416 North State Street  
Jackson, Mississippi 39201

CODED

WATER WELL DRILLERS LOG

April 3 19 72 Green Water Well Co. Walthall  
date well completed firm name county well located

LANDOWNER: <u>C. M. Sartini Sr.</u> <u>Rt 3</u>	description of formations encountered	from	to
Jagers Min (mailing address)	Red sand clay + Gravel	0	120
WELL LOCATION: sec <u>5</u> T <u>4</u> <u>N</u> R <u>11</u> <u>E</u> <u>18</u> miles <u>N</u> of <u>Tylertown</u> (distance) (direction) (nearest town)			
WELL PURPOSE: <u>Home</u> (home, irrigation, municipal, industrial)			
WELL COMPLETION DATA:			
(1) diameter (inches) <u>6"</u>			
(2) total depth (feet) <u>120</u>			
(3) static water level (feet) <u>70</u> <u>below</u> above-top of ground.			
(4) casing <u>PVC</u> , <u>100</u> , (material) (depth) <u>4"</u> (size) if telescope see back.			
(5) screen <u>6'</u> , <u>100</u> (length) (depth to top)			
<u>.010</u> , <u>PVC</u> (size) (material)			
(6) pump <u>1/2 sub</u> , <u>7</u> (HP) (yield gpm)			
<u>Electric</u> (type power)			
(7) electric log <u>no</u> (yes or no)			
(organization running log)			
(8) how well bottom plugged <u>Wood</u>			
DRILLERS REMARKS:			


CODED

JUN 13 1972

MISS. BD. OF  
WATER COMM.

If well telescopes please sketch and show depths.

GROUND LEVEL

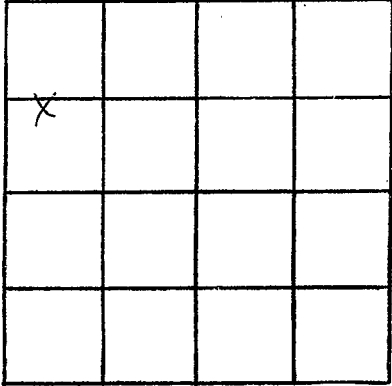

SECTION 61

Please indicate well location X.

ADDITIONAL INFORMATION

If more than one screen, show locations of each on sketch.