

WALTHALL
B 31
6-22-72

MISSISSIPPI
BOARD OF WATER COMMISSIONERS
416 North State Street
Jackson, Mississippi 39201

WATER WELL DRILLERS LOG

January 1972 Chatter Keener Walthall
date well completed firm name county well located

LANDOWNER: S. Smith
Methodist Church
ATD Hayes
(mailing address)

description of formations encountered	from	to
Chalk	0	10
Sand & gravel	10	25
Red Sand	25	90
Sandy chalk	90	100
Sand & gravel	100	123

WELL LOCATION:
sec. 8 T. 4 N. R. 11 E.
at Sattenville
(distance) miles (direction) (nearest town)

WELL PURPOSE: Church Home
(home, irrigation, municipal, industrial)

- WELL COMPLETION DATA:
- (1) diameter (inches) 4"
 - (2) total depth (feet) 123
 - (3) static water level (feet) 68 below top of ground.
 - (4) casing Plast. Ballans (material) (depth)
 - (size) If telescope see back.
 - (5) screen 6' (length) 117' (depth to top)
14" (size) Plast (material)
 - (6) pump 1/2 sub (HP) 15 (yield gpm)
Elect (type power)
 - (7) electric log NO (yes or no)

(organization running log)

(8) how well bottom plugged wooden plug


DRILLERS REMARKS: red well hole

MADE 90 1972

MISS. BD. OF
WATER COMM.

If well telescopes please sketch and show depths.

GROUND LEVEL

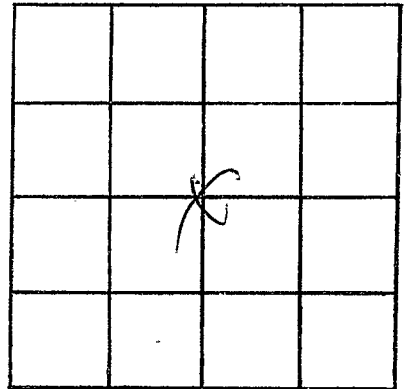

SECTION 8

Please indicate well location X.

ADDITIONAL INFORMATION

If more than one screen, show locations of each on sketch.