

WALTHALL
B32
11-16-72

MISSISSIPPI
 BOARD OF WATER COMMISSIONERS
 416 North State Street
 Jackson, Mississippi 39201

CODED

WATER WELL DRILLERS LOG

16 Nov. 1972
 date well completed

J. T. Covington, Jr.
 firm name


Walthall
 county well located

LANDOWNER:	description of formations encountered	from	to
Grand Magall Tylerton Miss (mailing address)	clay red sand clay chalk sandy sand brush	0 10 20 65	10 20 65 85
WELL LOCATION: sec. <u>35</u> T. <u>4</u> N R. <u>14</u> E <u>6</u> miles <u>N</u> of <u>Tylerton</u> (distance) (direction) (nearest town)			
WELL PURPOSE: (home, irrigation, municipal, industrial)			
WELL COMPLETION DATA: (1) diameter (inches) <u>4</u> (2) total depth (feet) <u>85</u> (3) static water level (feet) <u>55</u> below top of ground. (4) casing <u>4</u> (material) <u>79</u> (depth) (size) If telescope see back. (5) screen <u>6</u> (length) <u>79</u> (depth to top) (size) (material) (6) pump <u>1/2</u> (HP) <u>8</u> (yield gpm) (type power) (7) electric log _____ (organization running log) (8) how well bottom plugged <u>wood</u>			
DRILLERS REMARKS:			

JAN 10 1973

If well telescopes please sketch and show depths.

GROUND LEVEL

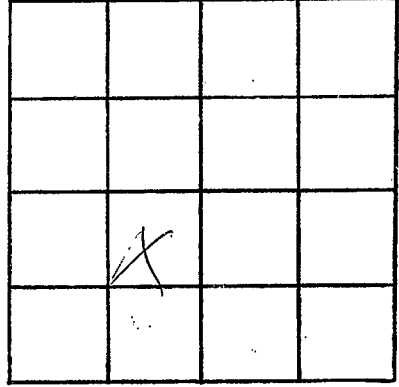

SECTION 35

Please indicate well location X.

ADDITIONAL INFORMATION

If more than one screen, show locations of each on sketch.