

WALTHALL  
B33  
1-23-73

MISSISSIPPI  
BOARD OF WATER COMMISSIONERS  
416 North State Street  
Jackson, Mississippi 39201

CODED

WATER WELL DRILLERS LOG

Jan 23 1973 date well completed  
chester keene firm name  
walthall county well located

LANDOWNER: Jerry Holmes  
RFD - 7  
Tylertown  
(mailing address)

description of formations encountered	from	to
red sandy clay	0	19
pink chalk	19	36
red sand	36	60
small gravel sand	60	80

WELL LOCATION:  
sec. 20 T 4 N R 11 E  
13 miles N of Tylertown  
(distance) (direction) (nearest town)

WELL PURPOSE: drain  
(home, irrigation, municipal, industrial)

WELL COMPLETION DATA:

- (1) diameter (inches) 4"
- (2) total depth (feet) 80
- (3) static water level (feet) 60 below top of ground
- (4) casing Plast. 4" (material) 80' (depth)  
if telescope see back.
- (5) screen 6" (length) 70' (depth to top)  
4" (size) Plast. (material)
- (6) pump By owner (HP) (yield gpm)  
(type power)
- (7) electric log NO (yes or no)

CODED

(organization running log)


(8) how well bottom plugged  
wood plug

DRILLERS REMARKS:  
New location

JAN 23 1973

If well telescopes please sketch and show depths.

GROUND LEVEL

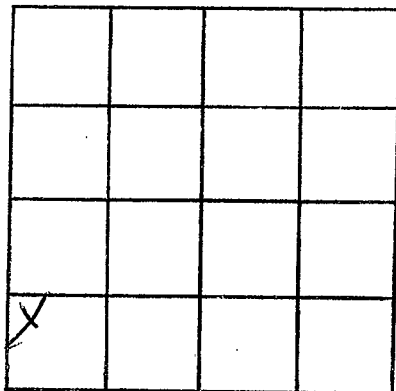

SECTION 20

Please indicate well location X.

ADDITIONAL INFORMATION

If more than one screen,  
show locations of each on sketch.