

**CODED**

MISSISSIPPI  
BOARD OF WATER COMMISSIONERS  
416 North State Street  
Jackson, Mississippi 39201

**WALTHALL**  
**B 34**  
**1-73**

**WATER WELL DRILLERS LOG**

Jan. 1973 E. B. Sheppard Walthall  
date well completed firm name county well located

**LANDOWNER:**  
Lester Langston  
Rt. 3 - Jayess, Miss.  
(mailing address)

**description of fomations encountered**  
SAND + GRAVEL  
TAILED  
from 0 to 91'

**WELL LOCATION:**  
sec 30 T 4 N R 11 E  
S W  
12 miles N of Jayertown  
(distance) (direction) (nearest town)

**WELL PURPOSE:**  
(home) irrigation, municipal, industrial

**WELL COMPLETION DATA:**

(1) diameter (inches) 2"

(2) total depth (feet) 91'

(3) static water level (feet) 60 below above top of ground.

(4) casing pl. 86'  
(material) (depth)  
2" if telescope see back.  
(size)

(5) screen 5' pl.  
(length) (depth to top)  
2" pl.  
(size) (material)

(6) pump 1 7  
(HP) (yield gpm)  
E  
(type power)

(7) electric log (yes or no)  
(organization running log)


(8) how well bottom plugged BWV

**CODED**

**DRILLERS REMARKS:**

If well telescopes please sketch and show depths.

GROUND LEVEL

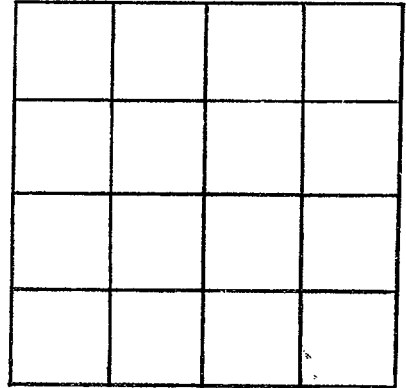

SECTION \_\_\_\_\_

Please indicate well location X.

ADDITIONAL INFORMATION

If more than one screen, show locations of each on sketch.