

WALTHALL

B 35

7-23-73

MISSISSIPPI
 BOARD OF WATER COMMISSIONERS
 416 North State Street
 Jackson, Mississippi 39201

CODED

WATER WELL DRILLERS LOG

12 April 1973 J. T. Compton Walthall
 date well completed firm name county well located

LANDOWNER:

Johnny Seale

Tylatom

(mailing address)

description of formations encountered

from

to

Clay	0	20
Clay shale	20	45
Sand	45	60
Shale	60	80
Shale	80	112

WELL LOCATION:

sec 30 T 4 N R 11 E
 3 miles T of Tylatom
 (distance) (direction) (nearest town)

WELL PURPOSE:

(home, irrigation, municipal, industrial)

WELL COMPLETION DATA:

- (1) diameter (inches) 4
- (2) total depth (feet) 112
- (3) static water level (feet) 75 below above top of ground.
- (4) casing PI 106 (material) (depth)
- _____ If telescope see back. (size)
- (5) screen 6 106 (length) (depth to top)
- 4 PI (size) (material)
- (6) pump 1/2 8 (HP) (yield gpm)
- Electric (type power)
- (7) electric log _____ (yes or no)

CODED

(organization running log)


(8) how well bottom plugged Wood

DRILLERS REMARKS:

JUL 17 1973

If well telescopes please sketch and show depths.

GROUND LEVEL

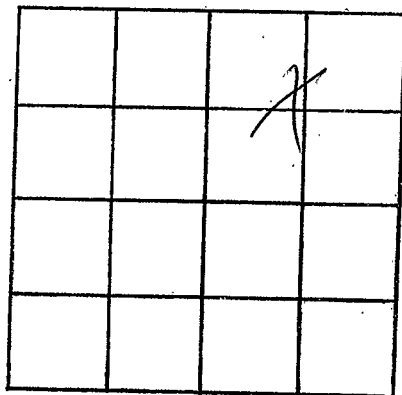

SECTION 30

Please indicate well location X.

ADDITIONAL INFORMATION

If more than one screen, show locations of each on sketch.