

MISSISSIPPI
BOARD OF WATER COMMISSIONERS
416 North State Street
Jackson, Mississippi 39201

CODED

WATER WELL DRILLERS LOG

WALTHALL
B 36
5-18-73

May 18 1973 Chester Keene Walthall
date well completed firm name county well located

LANDOWNER: Assistant Army
RTD Tylertown

description of formations encountered	from	to
Red Clay	0	19
Red Sand	19	76
Sand & gravel	76	88
Chalk & gravel	88	95
Small gravel & sand	95	101

(mailing address)

WELL LOCATION:
sec. 19 T. 4 N. R. 11 E
1 1/2 miles N Tylertown
(distance) (direction) (nearest town)

WELL PURPOSE: Home
(home, irrigation, municipal, industrial)


WELL COMPLETION DATA:

- (1) diameter (inches) 4"
- (2) total depth (feet) 101
- (3) static water level (feet) 65 below above top of ground.
- (4) casing Plast. Balltown
(material) (depth)
- (size) if telescope see back.
- (5) screen 6' 95'
(length) (depth to top)
- 4" Plast
(size) (material)
- (6) pump 1/2 Sub 12
(HP) (yield gpm)
- Elect
(type power)
- (7) electric log no
(yes or no)

CODED

(organization running log)


(8) how well bottom plugged
was plugged
DRILLERS REMARKS: New house

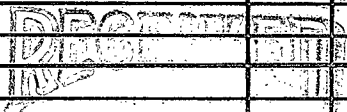

MAY 24 1974

If well telescopes please sketch and show depths.

GROUND LEVEL

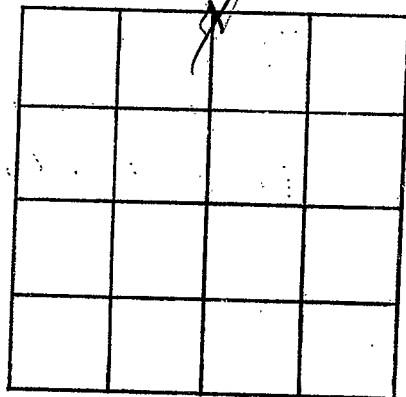

SECTION 19

Please indicate well location X.

ADDITIONAL INFORMATION

If more than one screen, show locations of each on sketch.