

WALTHALL  
B37  
2-2-74

MISSISSIPPI  
BOARD OF WATER COMMISSIONERS  
416 North State Street  
Jackson, Mississippi 39201

CODED

WATER WELL DRILLERS LOG

2-2 1974 date well completed  
GRINER - GINN firm name  
Walthall county well located


LANDOWNER:	description of formations encountered	from	to
Valmont Laundry	top Soil	0	1
Rt. 1	Clay	1	34
(mailing address) Jayess, Miss.	Clay + gravel	34	70
	Shell	70	101
	Sand	101	120
<b>WELL LOCATION:</b>			
sec. 5 T. 4 N. R. 11 E			
4 miles SW of Jayess (distance) (direction) (nearest town)			
<b>WELL PURPOSE:</b> Home (home, irrigation, municipal, industrial)			
<b>WELL COMPLETION DATA:</b>			
(1) diameter (inches) 4"			
(2) total depth (feet) 120			
(3) static water level (feet) 70 below above top of ground.			
(4) casing plastic, 110 (material) (depth)			
4" (size) if telescope see back.			
(5) screen 10' 110 (length) (depth to top)			
4" plastic (size) (material)			
(6) pump 3/4 10 (HP) (yield gpm)			
elec (type power)			
(7) electric log NO (yes or no)			
NO (organization running log)			
(8) how well bottom plugged B.W. Valve			
<b>DRILLERS REMARKS:</b>			

CODED

MAY 23 1974  
MISS. BD. OF WATER COMMISSIONERS

If well telescopes please sketch and show depths.

GROUND LEVEL

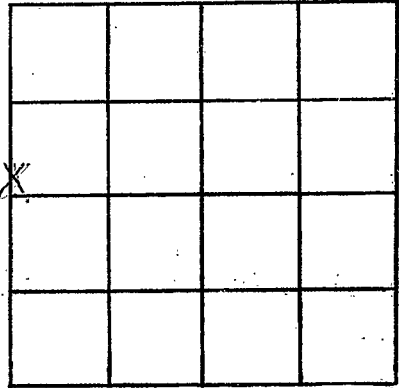

SECTION 5

Please indicate well location X.

ADDITIONAL INFORMATION

If more than one screen,  
show locations of each on sketch.