

WALTHALL
B39
5178

MISSISSIPPI
BOARD OF WATER COMMISSIONERS
416 North State Street
Jackson, Mississippi 39201

CODED
CODED

WATER WELL DRILLERS LOG

May 1974
date well completed

74

E. B. Sherrard
firm name

Walthall
county well located

LANDOWNER:

Herman Halmes
Rt. 3 - Jayess, Ms.
(mailing address)

description of formations encountered

SAND & GR. 0 80'

from to

WELL LOCATION:

sec 23 T 4 N R 11 E
S W
12 miles NE Jayess
(distance) (direction) (nearest town)

WELL PURPOSE:

(Home) Irrigation, municipal, industrial

WELL COMPLETION DATA:

- (1) diameter (inches) 2"
- (2) total depth (feet) 80'
- (3) static water level (feet) 38' below top of ground
- (4) casing pl. 25' (material) (depth)
2" (size) if telescope see back.
- (5) screen 5' (length) (depth to top)
2" (size) pl. (material)
- (6) pump 1 (HP) 7 (yield gpm)
E (type power)
- (7) electric log (yes or no)

CODED

(organization running log)

(8) how well bottom plugged BWW


DISGENTIFIED
RIS
JUL - 1 1974

DRILLERS REMARKS:

MISS. BD. OF WATER COMMISSIONERS

If well telescopes please sketch and show depths.

GROUND LEVEL

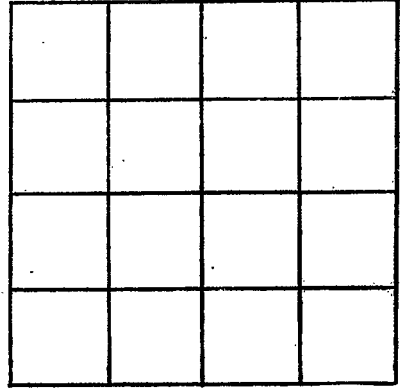

SECTION _____

Please indicate well location X.

ADDITIONAL INFORMATION

If more than one screen, show locations of each on sketch.