

WALTHALL
B 40
5-16-74

MISSISSIPPI
 BOARD OF WATER COMMISSIONERS
 416 North State Street
 Jackson, Mississippi 39201


WATER WELL DRILLERS LOG **CODED**

5-16 1974 Maenen - Minn Walthall
 date well completed firm name county well located

LANDOWNER:	description of formations encountered	from	to
<u>Mrs. Bunley Crawford</u>	<u>top soil</u>	<u>0</u>	<u>1</u>
<u>Rt. 1, Box 181</u>	<u>clay</u>	<u>1</u>	<u>30</u>
<u>Julesburg</u>	<u>clay & chert</u>	<u>30</u>	<u>89</u>
<u>(mailing address) Miss.</u>	<u>sand.</u>	<u>89</u>	<u>123</u>
WELL LOCATION:			
sec. <u>20</u> T <u>4</u> N R <u>11</u> E			
<u>6</u> miles <u>S</u> of <u>Julesburg</u>			
(distance) (direction) (nearest town)			
WELL PURPOSE: <u>Home</u>			
(home, irrigation, municipal, industrial)			
WELL COMPLETION DATA:			
(1) diameter (inches) <u>2"</u>	CODED		
(2) total depth (feet) <u>123</u>			
(3) static water level (feet) <u>70</u> below top of ground.			
(4) casing <u>plastic</u> , <u>113</u> (material) (depth)			
<u>2"</u> (size) if telescope see back.			
(5) screen <u>10'</u> , <u>113</u> (length) (depth to top)			
<u>2"</u> (size), <u>plastic</u> (material)			
(6) pump <u>1</u> , <u>6</u> (HP) (yield gpm)			
<u>elec</u> (type power)	DISCONTINUED		
(7) electric log <u>NO</u> (yes or no)			
<u>NO</u> (organization running log)	DEC 26 1974		
(8) how well bottom plugged <u>B.W. Valve</u>			
DRILLERS REMARKS:			

If well telescopes please sketch and show depths.

GROUND LEVEL

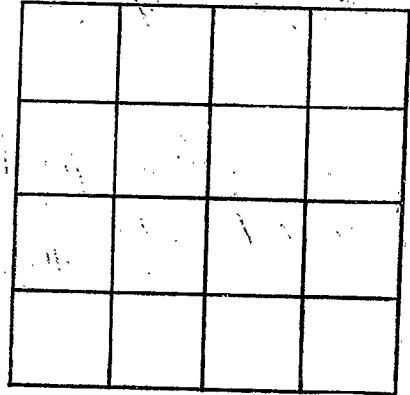

SECTION _____

Please indicate well location X.

ADDITIONAL INFORMATION

A series of horizontal lines for entering additional information, starting below the 'ADDITIONAL INFORMATION' header.

If more than one screen, show locations of each on sketch.