

Claude H. ... Job

WALTHALL  
B 42  
7-6-74

MISSISSIPPI  
BOARD OF WATER COMMISSIONERS  
416 North State Street  
Jackson, Mississippi 39201

CODED

WATER WELL DRILLERS LOG

July 20 1974 Chatterkeweenaw Walthall  
date well completed firm name county well located

LANDOWNER: Ted Bazeman  
RFD - Tylertown  
(mailing address)

WELL LOCATION:  
sec. 10 T 4 N R 11 E  
8 miles North of Tylertown  
(distance) (direction) (nearest town)

WELL PURPOSE: drank  
(home, irrigation, municipal, industrial)

- WELL COMPLETION DATA:
- (1) diameter (inches) 4"
  - (2) total depth (feet) 170
  - (3) static water level (feet) 29 below top of ground.
  - (4) casing plastic ballast  
(material) (depth)
  - (size) If telescope see back.
  - (5) screen 6' 114  
(length) (depth to top)
  - plastic  
(size) (material)
  - (6) pump hydrotest  
(HP) (yield gpm)
  - (type power)
  - (7) electric log NR  
(yes or no)
  - (organization running log)
  - (8) how well bottom plugged wooden plug

description of formations encountered	from	to
Red clay	0	16
Brown sand	16	30
Sand & gravel	30	44
limb chalk	44	67
laminated sand	67	108
Coarse sand	108	170


CODED

RECEIVED  
FEB 26 1975

DRILLERS REMARKS:  
New house

If well telescopes please sketch and show depths.

GROUND LEVEL

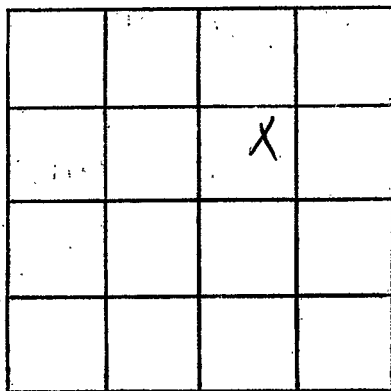

SECTION 10

Please indicate well location X.

ADDITIONAL INFORMATION

If more than one screen, show locations of each on sketch.