

WALTHALL  
B43  
11-26-74

MISSISSIPPI  
BOARD OF WATER COMMISSIONERS  
416 North State Street  
Jackson, Mississippi 39201

CODED

WATER WELL DRILLERS LOG

Nov. 26 1974 *Chertok* Walthall  
date well completed firm name county well located

LANDOWNER:  
*Mr. Arthur Holmes*  
*Rt. Tylitown*  
(mailing address)

description of formations encountered	from	to
<i>Red sandy Clay</i>	<i>0</i>	<i>26</i>
<i>Red sand</i>	<i>26</i>	<i>58</i>
<i>Gravel &amp; sand</i>	<i>55</i>	<i>62</i>
<i>fine pebbles</i>	<i>62</i>	<i>105</i>
<i>Small gravel &amp; sand</i>	<i>105</i>	<i>120</i>


WELL LOCATION:  
sec *29* T *4* N R *11* E  
*11* miles *north* of *Tylitown*  
(distance) (direction) (nearest town)

WELL PURPOSE: *Home*  
(home, irrigation, municipal, industrial)

CODED

- WELL COMPLETION DATA:
- (1) diameter (inches) *4"*
  - (2) total depth (feet) *120'*
  - (3) static water level (feet) *55* below top of ground.
  - (4) casing *Plastic, Cotton*  
(material) (depth)
  - (size) If telescope see back.
  - (5) screen *6"*, *114*  
(length) (depth to top)
  - 1/2"*, *Plastic*  
(size) (material)
  - (6) pump *3/4 HP*, *6*  
(type) (yield gpm)
  - elect*  
(type power)
  - (7) electric log *no*  
(yes or no)
  - (organization running log)
  - (8) how well bottom plugged  
*wooden plug*

DRILLERS REMARKS:  
*old well filled up with sand*

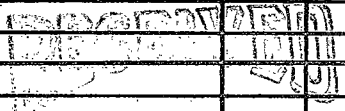

MAR 31 1975

If well telescopes please sketch and show depths.

GROUND LEVEL

X			

SECTION 29

Please indicate well location X.

ADDITIONAL INFORMATION

If more than one screen,  
show locations of each on sketch.