

B 45
 Walthall
 4-5-75

MISSISSIPPI
 BOARD OF WATER COMMISSIONERS
 416 North State Street
 Jackson, Mississippi 39201

CODED

WATER WELL DRILLERS LOG

5 April 1975
 date well completed

Ames Fabrik Drilling
 firm name

Walthall
 county well located

LANDOWNER:

Elmer Howell

Tylertown
 (mailing address)

description of formations encountered

from

to

Clay
 sand
 clay
 sand

| | |
|----|----|
| 0 | 70 |
| 90 | 45 |
| 45 | 57 |
| 55 | 94 |

WELL LOCATION:

sec. 29 T. 4 N R. 11 E
 1.0 miles N of Tylertown
 (distance) (direction) (nearest town)

WELL PURPOSE:

(home, irrigation, municipal, industrial)

WELL COMPLETION DATA:

- (1) diameter (inches) 4
- (2) total depth (feet) 94
- (3) static water level (feet) 70 below above top of ground.
- (4) casing PI 88
 (material) (depth)
 (size) if telescope see back.
- (5) screen 6 88
 (length) (depth to top)
- 4 PI
 (size) (material)
- (6) pump 1/2 8
 (HP) (yield gpm)
split
 (type power)
- (7) electric log _____
 (yes or no)
 (organization running log)
- (8) how well bottom plugged wood


DRILLERS REMARKS:

RECEIVED
 RECEIVED

JUN 6 1975

If well telescopes please sketch and show depths.

GROUND LEVEL

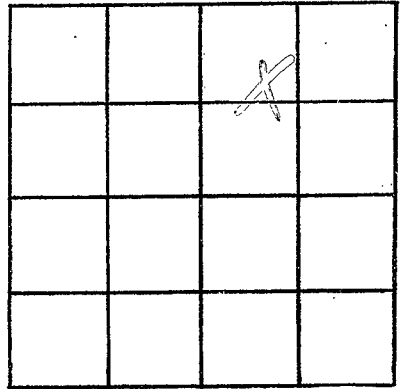

SECTION 2.8

Please indicate well location X.

ADDITIONAL INFORMATION

If more than one screen,
show locations of each on sketch.