

Walthall
 R 46
 6-30-75

MISSISSIPPI
 BOARD OF WATER COMMISSIONERS
 416 North State Street
 Jackson, Mississippi 39201

CODED

WATER WELL DRILLERS LOG

June 30 1975 *Remondville & Son Walthall*
 date well completed firm name county well located

LANDOWNER:
Elise Pittip
At 3 Jayess
 (mailing address)

description of formations encountered	from	to
<i>Red Clay</i>	<i>0</i>	<i>15</i>
<i>Red sand</i>	<i>15</i>	<i>25</i>
<i>Sand & gravel</i>	<i>25</i>	<i>76</i>
<i>pink Chalk</i>	<i>76</i>	<i>100</i>
<i>fragments sand</i>		

WELL LOCATION:
 sec. *18* T. *4* N R. *11 E* *134*
2 miles *S-SE* of *SANTON*
 (distance) (direction) (nearest town)

WELL PURPOSE: *home*
 (home, irrigation, municipal, industrial)

WELL COMPLETION DATA:

(1) diameter (inches) *4"*

(2) total depth (feet) *124*

(3) static water level (feet) *70* below top of ground.

(4) casing *plastic bottom*
 (material) (depth)

— if telescope see back.
 (size)

(5) screen *6'* *118*
 (length) (depth to top)

4" *plastic*
 (size) (material)

(6) pump *100* *8*
 (HP) (yield gpm)


elect.
 (type power)

(7) electric log *no*
 (yes or no)

—
 (organization running log)


(8) how well bottom plugged
wood chips

DRILLERS REMARKS:
2" well rusty

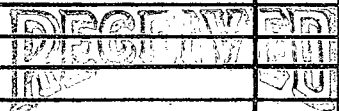

If well telescopes please sketch and show depths.

GROUND LEVEL

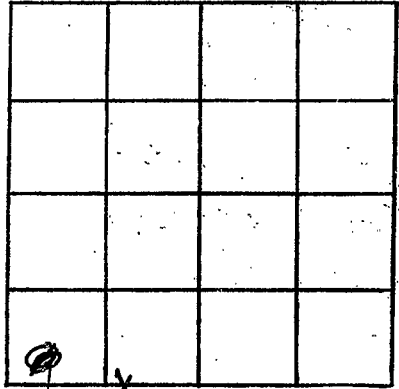

SECTION 28

Please indicate well location X.

ADDITIONAL INFORMATION

If more than one screen, show locations of each on sketch.