

WALTHALL

B50

9/15/80

MISSISSIPPI BOARD OF WATER COMMISSIONERS
416 North State Street
Jackson, Mississippi 39201

CODED

WATER WELL DRILLERS LOG

Sept 15 - 1979 Reuss Well Ser Walthall
date well completed firm name county well located

LANDOWNER:	description of formations encountered	from	to
<u>B. B. Thompson</u> <u>At. N. Korman</u> (mailing address)			
WELL LOCATION: sec <u>36</u> T <u>4</u> N R <u>11</u> E <u>in</u> miles <u>of</u> <u>Barbon</u> (distance) (direction) (nearest town)			
WELL PURPOSE: <u>home</u> (home, irrigation, municipal, industrial)			
WELL COMPLETION DATA: (1) diameter (inches) <u>4 1/2"</u> (2) total depth (feet) <u>82</u> (3) static water level (feet) <u>26</u> below above top of ground. (4) casing <u>plastic bottom</u> (material) (depth) (size) If telescope see back. (5) screen <u>5'</u> <u>77'</u> (length) (depth to top) <u>4"</u> <u>plastic</u> (size) (material) (6) pump <u>by alpha</u> (HP) (yield gpm) <u>slut</u> (type power) (7) electric log <u>no</u> (yes or no) (organization running log) (8) how well bottom plugged <u>wooden plug</u>			
DRILLERS REMARKS: <u>[Signature]</u>			


CODED

DEPT. OF NATURAL RESOURCES
BUREAU OF LAND & WATER RESOURCES

SEP 2 - 1980
RECEIVED

If well telescopes please sketch and show depths.

GROUND LEVEL

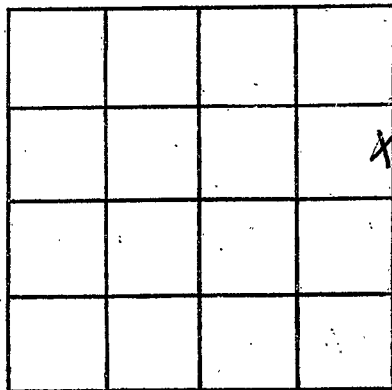

SECTION 36

Please indicate well location X.

ADDITIONAL INFORMATION

If more than one screen, show locations of each on sketch.