

MISSISSIPPI DEPARTMENT OF NATURAL RESOURCES

Bureau of Land and Water Resources

Southport Mall

P.O. Box 10631

Jackson, Mississippi 39209

WATER WELL DRILLERS LOG

9 CODED

Walthall  
B51  
6-30-81

6-30-81 date well completed

Griner Drilling Service, Inc. firm name

Walthall county well located

LANDOWNER:

Prest Production  
1515 Capital Towers  
Jackson, Ms 39205  
(mailing address)

description of formations encountered

from

to

sand + gravel 0 210

chalk 210 240

WELL LOCATION: 1500' N + 1500' W

sec. 33 T. 40 S. R. 11 E. of sec. 4

North Hulsan Field (nearest town)

sand, pea gravel 240 310

rock + chalk 310 336

WELL PURPOSE:

(home, irrigation, municipal, industrial)

WELL COMPLETION DATA:

(1) diameter (inches) 4"

(2) total depth (feet) 336'

(3) static water level (feet) 30' below top of ground.

(4) casing Steel 294' (material) (depth)

4" (size) if telescope see back.

(5) screen 42' 252' (length) (depth to top)

4" perforated (size) (material)

(6) pump 80-90 (HP) (yield gpm)

AC (type power)

(7) electric log (yes or no)


(organization running log)

(8) how well bottom plugged orange

peel


DRILLERS REMARKS:

CODED

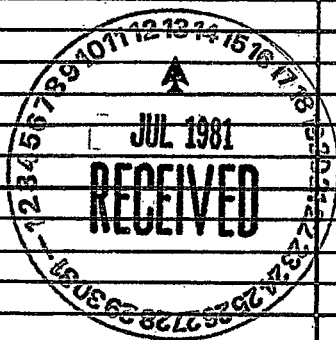

If well telescopes please sketch and show depths.

GROUND LEVEL

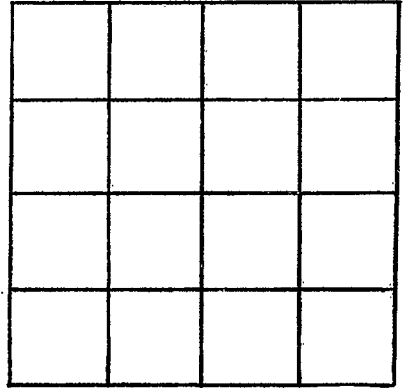

SECTION \_\_\_\_\_

Please indicate well location X.

ADDITIONAL INFORMATION

If more than one screen,  
show locations of each on sketch.