

MISSISSIPPI DEPARTMENT OF NATURAL RESOURCES

Bureau of Land and Water Resources

Southport Mall

P.O. Box 10631

**CODED**

Jackson, Mississippi 39209

**WATER WELL DRILLERS LOG**

B52  
WALTHAL  
5-31-84

5-31  
 date well completed

1984 Fitzgerald Well Serv  
 firm name

Walthal  
 county well located

LANDOWNER:	description of formations encountered	from	to
<u>Donald Finn</u>			
<u>P.O. Gulletown, MS.</u> (mailing address)	<u>Red clay</u>	<u>0</u>	<u>20</u>
	<u>Red sand</u>	<u>20</u>	<u>20</u>
	<u>Red gravel</u>	<u>20</u>	<u>95</u>
	<u>Coarse sand &amp; gravel</u>	<u>95</u>	<u>120</u>
WELL LOCATION:			
sec. <u>26</u> T. <u>4</u> N. S. R. <u>11</u> E. W.			
<u>3</u> miles <u>W</u> of <u>Darben</u> (distance) (direction) (nearest town)			
WELL PURPOSE:			
(home, irrigation, municipal, industrial) <u>Home</u>			
WELL COMPLETION DATA:			
(1) diameter (inches) <u>4</u>			
(2) total depth (feet) <u>120</u>			
(3) static water level (feet) <u>85</u> below above top of ground.			
(4) casing <u>PVC</u> , <u>112</u> , (material) (depth)			
<u>4</u> if telescope see back. (size)			
(5) screen <u>8</u> , <u>112</u> (length) (depth to top)			
<u>4</u> , <u>PVC</u> (size) (material)			
(6) pump <u>1/2</u> , <u>10</u> (HP) (yield gpm)			
<u>Electric</u> (type power)			
(7) electric log <u>No</u> (yes or no)			
(organization running log)			
(8) how well bottom plugged <u>Sal Hk</u>			
DRILLERS REMARKS:			


DEPARTMENT OF NATURAL RESOURCES  
 BUREAU OF LAND & WATER RESOURCES

JUN 15 1984

**RECEIVED**

If well telescopes please  
sketch and show depths.

GROUND LEVEL

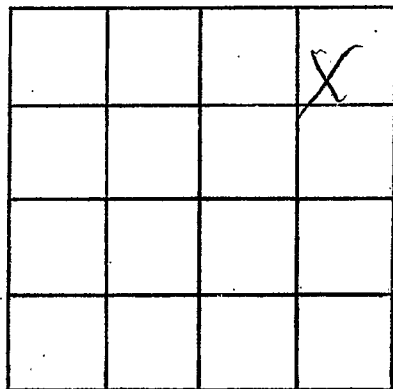

SECTION 26

Please indicate well location X.

ADDITIONAL INFORMATION

If more than one screen,  
show locations of each on sketch.