

MISSISSIPPI DEPARTMENT OF NATURAL RESOURCES

Bureau of Land and Water Resources

Southport Mall

P.O. Box 10631

Jackson, Mississippi 39209

WATER WELL DRILLERS LOG

CODED

WALTHALL  
B 53  
12-31-86

12-31-86 19 Tom Griffith Well Ser Walthall  
date well completed firm name county well located

LANDOWNER: Texaco

description of formations encountered

from

to

PO Box 457  
New Iberia La 705610457  
705610457  
(mailing address)

Red Sand	1	105
P. Gravel	105	190
Clay	190	195
P. Gravel	195	300

WELL LOCATION:

sec. 28 T. 4 (N) S. R. 11 (E) W.  
10 3/4 miles N of Columbia  
(distance) (direction) (nearest town)

CODED

WELL PURPOSE: Oil Rec  
(home, irrigation, municipal, industrial)

WELL COMPLETION DATA:

(1) diameter (inches) 4"  
(2) total depth (feet) 300'  
(3) static water level (feet) 70' below top of ground.

1150'S + 791'E 1/4 NW corner

(4) casing PVC, 260  
(material) (depth)

n/a if telescope see back.  
(size)

(5) screen 40, 260  
(length) (depth to top)

4", PVC  
(size) (material)

(6) pump air lift, 90  
(HP) (yield gpm)

diesel  
(type power)

(7) electric log NO  
(yes or no)

NA  
(organization running log)

(8) how well bottom plugged BWU

RECEIVED


SEP 24 1987

Department of Natural Resources  
Bureau of Land & Water Resources

DRILLERS REMARKS:

If well telescopes please sketch and show depths.

GROUND LEVEL

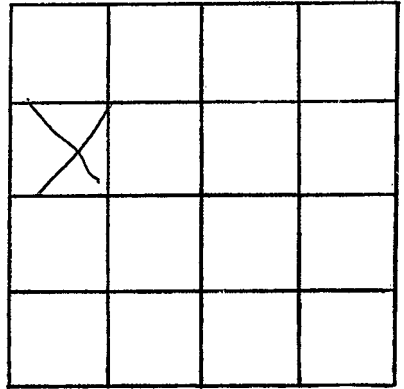

SECTION 28

Please indicate well location X.

ADDITIONAL INFORMATION

If more than one screen,  
show locations of each on sketch.