

MISSISSIPPI BOARD OF WATER COMMISSIONERS

B 2000

WATER WELL DRILLERS LOG

10-26

Date: ~~11-26~~ 1962, Driller: E.B. SHERRARD County WALTHALL

(Name)

(1) Owner of Land:	Description & Color of Materials Sand, Clay, Red Clay, Shell, etc.	Thick- ness Feet	Depth Feet
J.W. RATCLIFF (Name)	RED SANDY CLAY		10
TYLER TOWN, MISS. (Address)	" " "		20
(2) Location: 1/4, 15-4-11, Sec. T R	" " "		30
19 miles N.W. of COLUMBIA (distance) (direction) (Nearest Town)	" " "		40
(3) Topography: <input checked="" type="checkbox"/> (Hilly) <input type="checkbox"/> (Flat) <input type="checkbox"/> (Level)	" " "		50
(4) Purpose of Well: DOMESTIC (Domestic Irrigation, Municipal, Industrial, Other)	SAND & GRAVEL		60
	" "		70
	" "		80
	" "		90
	" "		100


Information upon completion of well:

- (1) Diameter 2" inches.
- (2) Total Depth 91' feet.
- (3) Water Level 52' feet below top of ground.
- (4) Cased to 91', Size 2"
- (5) Screen: Size 2", Length 5'
- (6) Were any formations sealed against pollution?
 yes, no.

If YES depth of formation: _____

Why: _____

Drillers Remarks: _____

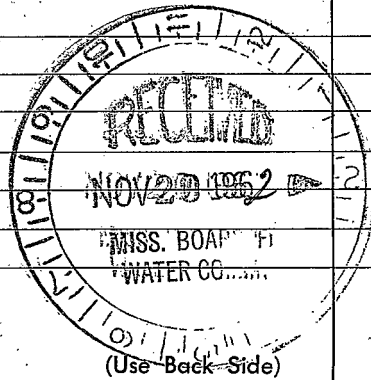

Well No.

