

WALTHALL

B 2002

10-22-75

MISSISSIPPI
BOARD OF WATER COMMISSIONERS
416 North State Street
Jackson, Mississippi 39201

WATER WELL DRILLERS LOG

Oct 22 1975
date well completed

134
Reems Well Service Walthall
firm name county well located


LANDOWNER:	description of formations encountered	from	to
Kester Helmes P.O. Fyleton (mailing address)			
WELL LOCATION:			
sec 32 T 4 N R 11 E 9 1/2 miles N of Fyleton (distance) (direction) (nearest town)			
WELL PURPOSE: Home (home, irrigation, municipal, industrial)			
WELL COMPLETION DATA:			
(1) diameter (inches) 4"			
(2) total depth (feet) 82			
(3) static water level (feet) 38 below top of ground			
(4) casing Plastro bottom (material) (depth)			
(5) screen 6" 76 ft (length) (depth to top)			
4" Plastro (size) (material)			
(6) pump 1/2 Sub 10 (HP) (yield gpm)			
Blunt (type power)			
(7) electric log No (yes or no)			
(organization running log)			
(8) how well bottom plugged Wooden plug			
DRILLERS REMARKS:			

RECEIVED
JAN 12 1976

MISS. BD. OF WATER COMMISSIONERS

If well telescopes please sketch and show depths.

GROUND LEVEL

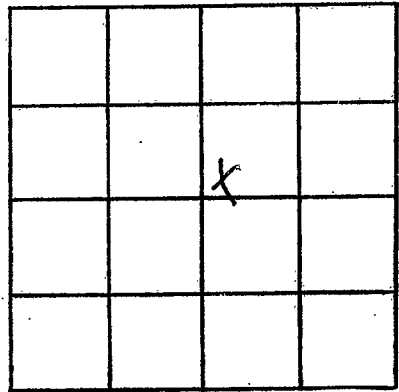

SECTION 32

Please indicate well location X.

ADDITIONAL INFORMATION

If more than one screen,
show locations of each on sketch.