

WALTHALL
 B 2004
 1-5-76

MISSISSIPPI
 BOARD OF WATER COMMISSIONERS
 416 North State Street
 Jackson, Mississippi 39201

WATER WELL DRILLERS LOG


Jan 5 1976 Reynolds Service Walthall
 date well completed firm name county well located

LANDOWNER:	description of formations encountered	from	to
<u>James Reed</u> <u>P.O. Tylertown</u> (mailing address)			
WELL LOCATION:			
sec <u>27</u> T <u>4</u> N R. <u>10</u> E #5 #2			
<u>11</u> miles <u>N-NW</u> of <u>Tylertown</u> (distance) (direction) (nearest town)			
WELL PURPOSE: <u>None</u> (home, irrigation, municipal, industrial)			
WELL COMPLETION DATA:			
(1) diameter (inches) <u>4</u>			
(2) total depth (feet) <u>113</u>			
(3) static water level (feet) <u>62</u> below top of ground.			
(4) casing <u>plastic bottom</u> (material) (depth)			
<u> </u> If telescope see back. (size)			
(5) screen <u>6'</u> <u>107</u> (length) (depth to top)			
<u>4</u> <u>plastic</u> (size) (material)			
(6) pump <u>1/2</u> <u>10</u> (HP) (yield gpm)			
<u>shot</u> (type power)			
(7) electric log <u>no</u> (yes or no)			
<u> </u> (organization running log)			
(8) how well bottom plugged <u>wooden plug</u>			
DRILLERS REMARKS: <u>2" plastic well</u> <u>cut lead</u>			

MISSISSIPPI
 BOARD OF WATER COMMISSIONERS

If well telescopes please sketch and show depths.

GROUND LEVEL

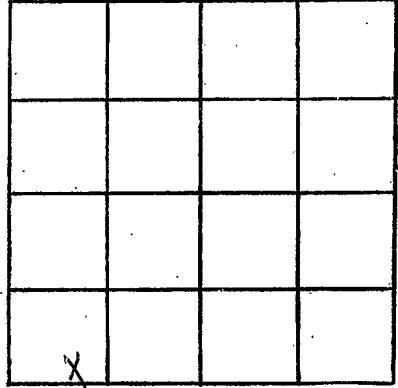

SECTION 11

Please indicate well location X.

ADDITIONAL INFORMATION

A series of horizontal lines for writing additional information, starting below the 'ADDITIONAL INFORMATION' header and extending to the bottom of the page.

If more than one screen, show locations of each on sketch.