

WALTHALL  
B 3005  
1-20-76

MISSISSIPPI  
 BOARD OF WATER COMMISSIONERS  
 416 North State Street  
 Jackson, Mississippi 39201

WATER WELL DRILLERS LOG

Jan-20 1976 Revere Well Ser Walthall  
 date well completed firm name county well located

LANDOWNER:  
Mr. Robbie Burnette  
Pt. Tetumner  
 (mailing address)

description of formations encountered	depth	
	from	to
<u>Red Clay</u>	<u>0</u>	<u>18</u>
<u>Red Sand</u>	<u>18</u>	<u>60</u>
<u>limestone &amp; Chalk</u>	<u>60</u>	<u>95</u>
<u>sand &amp; gravel</u>	<u>95</u>	<u>115</u>

WELL LOCATION:  
 sec. 19 T. 4 N. R. 11 E  
3 miles S-E-W of Sartwell  
 (distance) (direction) (nearest town)

WELL PURPOSE: Home  
 (home, irrigation, municipal, industrial)

- WELL COMPLETION DATA:
- (1) diameter (inches) 4"
  - (2) total depth (feet) 115
  - (3) static water level (feet) 80 below top of ground.
  - (4) casing plastic (material) bottom (depth)
  - (5) screen 6' (length) 109 (depth to top)
  - 4" (size) plastic (material)
  - (6) pump braker (HP) (yield gpm)
  - elect (type power)
  - (7) electric log no (yes or no)


(organization running log)  
 (8) how well bottom plugged  
medium plug  
 DRILLERS REMARKS:  
new house



MISS. BD. OF WATER COMMISSIONERS

If well telescopes please sketch and show depths.

GROUND LEVEL

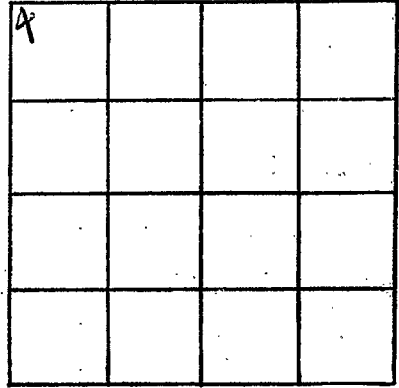

SECTION

19

Please indicate well location X.

ADDITIONAL INFORMATION

If more than one screen, show locations of each on sketch.