


Walthall
 B 2000
 1/29/76

MISSISSIPPI
 BOARD OF WATER COMMISSIONERS
 416 North State Street
 1381 Jackson, Mississippi 39201

WATER WELL DRILLERS LOG

Jan 29 1976 *Reverwell Drilling Walthall*
 date well completed firm name county well located


LANDOWNER:	description of formations encountered	from	to
<i>Rev. Bunnfield</i> <i>Rt- Fayetteville</i> (mailing address)			
WELL LOCATION: sec <u>32</u> T <u>4</u> N R <u>11</u> E <u>10 1/2</u> miles <u>N</u> of <u>Fayetteville</u> (distance) (direction) (nearest town)			
WELL PURPOSE: <u>Trailer</u> (home, irrigation, municipal, industrial)			
WELL COMPLETION DATA: (1) diameter (inches) <u>4</u> (2) total depth (feet) <u>40</u> (3) static water level (feet) <u>33</u> <u>above</u> top of ground. (4) casing <u>plastic</u> <u>bottom</u> (material) (depth) <u>—</u> if telescope see back. (size) (5) screen <u>6'</u> <u>34ft</u> (length) (depth to top) <u>4</u> <u>plastic</u> (size) (material) (6) pump <u>1/2 HP</u> <u>6</u> (HP) (yield gpm) <u>elect</u> (type power) (7) electric log <u>no</u> (yes or no) <u>—</u> (organization running log) (8) how well bottom plugged <u>wooden plug</u>			
DRILLERS REMARKS: <u>no</u> <u>present</u> <u>well</u>			

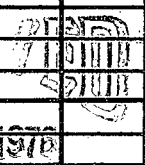

JAN 10 1976

If well telescopes please sketch and show depths.

GROUND LEVEL

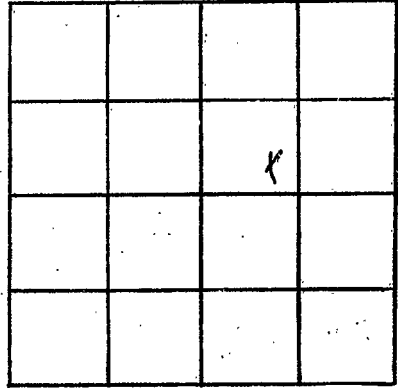

SECTION 32

Please indicate well location X.

ADDITIONAL INFORMATION

If more than one screen, show locations of each on sketch.