

Walshall
B 2007
3/12/76

MISSISSIPPI
 BOARD OF WATER COMMISSIONERS
 416 North State Street
 Jackson, Mississippi 39201

WATER WELL DRILLERS LOG
 GRINER - GINN

Walshall
Marion

3-12 1976
 date well completed

firm name

county well located

LANDOWNER:
hou Ella Brister
Rt. 1, Kokomo, Miss.
 (mailing address)

description of formations encountered	from	to
<u>Top Soil</u>	<u>0</u>	<u>1</u>
<u>Clay loam</u>	<u>1</u>	<u>19</u>
<u>Clay</u>	<u>19</u>	<u>31</u>
<u>Chalk</u>	<u>21</u>	<u>96</u>
<u>Gravel & sand</u>	<u>96</u>	<u>130</u>
<u>Chalk</u>	<u>130</u>	<u>180</u>
<u>Sand</u>	<u>180</u>	<u>225</u>

WELL LOCATION:
 sec. 10 T N R 11 E
S W
3 miles NE of Spartanburg
 (distance) (direction) (nearest town)

WELL PURPOSE: Home
 (home, irrigation, municipal, industrial)

WELL COMPLETION DATA:

(1) diameter (inches) 2"

(2) total depth (feet) 225

(3) static water level (feet) 145 below top of ground.

(4) casing PVC, 215,
 (material) (depth)
2" If telescope see back.
 (size)

(5) screen 10", 215
 (length) (depth to top)
2", PVC
 (size) (material)

(6) pump 1 1/2, 9 ✓
 (HP) (yield gpm)
elec
 (type power)

(7) electric log NO
 (yes or no)

(organization running log)

(8) how well bottom plugged
B.W. valve


DRILLERS REMARKS:

RECEIVED
 OCT 12 1976

MISS. BD. OF WATER COMMISSIONERS

If well telescopes please sketch and show depths.

GROUND LEVEL

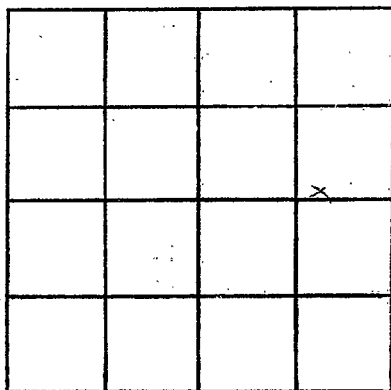

SECTION 10

Please indicate well location X.

ADDITIONAL INFORMATION

If more than one screen, show locations of each on sketch.