

WALTHALL
 B 2008
 3/1/76

MISSISSIPPI
 BOARD OF WATER COMMISSIONERS
 416 North State Street
 Jackson, Mississippi 39201

WATER WELL DRILLERS LOG

March 1976 EB Sheward Walthall
 date well completed firm name county well located

LANDOWNER:
 D. H. Bradshaw
 Sylertown, Miss.
 (mailing address)

WELL LOCATION:
 sec 28 T 4 N R 11 E
 S
 12 miles N Sylertown
 (distance) (direction) (nearest town)

WELL PURPOSE:
 (home, irrigation, municipal, industrial)

- WELL COMPLETION DATA:
- (1) diameter (inches) 4"
 - (2) total depth (feet) 130'
 - (3) static water level (feet) 40' ^{below} above top of ground.
 - (4) casing pl. 120' (material) (depth)
 4" (size) If telescope see back.
 - (5) screen 10' (length) (depth to top)
 4" (size) pl. (material)
 - (6) pump 1 (HP) 20 (yield gpm)
 elec. (type power)
 - (7) electric log (yes or no) no
 - (organization running log)
 - (8) how well bottom plugged BWV


description of fomations encountered	from	to
GRAY CLAY	0	25'
RED CLAY MIXED WITH MED SAND	25	80'
SMALL SAND	80	95'
COARSE SAND & GRAVEL	95'	130'

RECEIVED
 OCT 18 1976
 MISS. BD. OF WATER COMMISSIONERS

DRILLERS REMARKS:

If well telescopes please sketch and show depths.

GROUND LEVEL

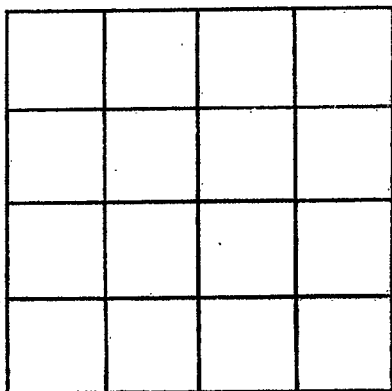

SECTION _____

Please indicate well location X.

ADDITIONAL INFORMATION

If more than one screen, show locations of each on sketch.