

Walthall  
B 2007  
7-30-76

MISSISSIPPI  
 BOARD OF WATER COMMISSIONERS  
 416 North State Street  
 1381 Jackson, Mississippi 39201

WATER WELL DRILLERS LOG

July 30 1976 Recess Well Sec Walthall  
 date well completed firm name county well located

LANDOWNER:	description of formations encountered	from	to
<u>Mr. Rue (Doc) Brumfield</u>			
<u>Pt. Tylertown</u> (mailing address)	<u>sand &amp; gravel</u>	<u>18</u>	<u>40</u>
	<u>pink Chalk</u>	<u>40</u>	<u>50</u>
	<u>sand &amp; gravel</u>	<u>50</u>	<u>62</u>
<b>WELL LOCATION:</b>			
sec. <u>31</u> T <u>4</u> N R <u>11</u> E			
<u>4</u> miles <u>South</u> of <u>Sartorisville</u>			
(distance) (direction) (nearest town)			
<b>WELL PURPOSE:</b> <u>Truckee</u>			
(home, irrigation, municipal, industrial)			
<b>WELL COMPLETION DATA:</b>			
(1) diameter (inches) <u>4"</u>			
(2) total depth (feet) <u>62</u>			
(3) static water level (feet) <u>33</u> below above top of ground.			
(4) casing <u>plastic, cotton</u>			
(material) (depth)			
<u>      </u> If telescope see back.			
(size)			
(5) screen <u>1'</u> <u>56</u>			
(length) (depth to top)			
<u>4"</u> <u>plastic</u>			
(size) (material)			
(6) pump <u>old pump used</u>			
(HP) (yield gpm)			
<u>electric</u>			
(type power)			
(7) electric log <u>no</u>			
(yes or no)			
<u>      </u>			
(organization running log)			
(8) how well bottom plugged <u>wooden plug</u>			
DRILLERS REMARKS: <u>well went dry</u>			


RECEIVED

OCT 26 1976

MISS. BD. OF WATER COMMISSIONERS

If well telescopes please sketch and show depths.

GROUND LEVEL

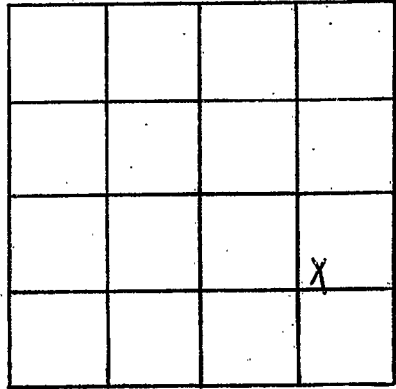

SECTION 31

Please indicate well location X.

ADDITIONAL INFORMATION

If more than one screen, show locations of each on sketch.