

Walthall  
B 2010  
8/19/76

MISSISSIPPI  
 BOARD OF WATER COMMISSIONERS  
 416 North State Street  
 Jackson, Mississippi 39201

WATER WELL DRILLERS LOG

8/19 1976 Hollinger Plunk Walthall  
 date well completed firm name county well located


LANDOWNER: <u>Jack Singley</u> <u>Darburn Rd.</u>	description of formations encountered	from	to
<u>Darburn, Miss.</u> (mailing address)	<u>clay</u>	<u>0</u>	<u>40</u>
WELL LOCATION: sec. <u>23</u> T- <u>4</u> (N) S R- <u>11</u> (E) W	<u>sand &amp; gravel</u>	<u>40</u>	<u>100</u>
<u>2</u> miles <u>N</u> of <u>Darburn</u> (distance) (direction) (nearest town)	<u>sand per gravel</u>	<u>100</u>	<u>140</u>
WELL PURPOSE: <u>Home</u> (home, irrigation, municipal, industrial)			
WELL COMPLETION DATA: (1) diameter (inches) <u>4"</u> (2) total depth (feet) <u>140</u> (3) static water level (feet) <u>125</u> (below/above top of ground) (4) casing <u>PVC</u> , <u>140</u> (material) (depth) _____ if telescope see back. (size)			
(5) screen <u>5</u> , <u>135</u> (length) (depth to top) <u>4"</u> , <u>PVC</u> (size) (material)			
(6) pump <u>3/4</u> , <u>15</u> (HP) (yield gpm) <u>elect.</u> (type power)			
(7) electric log _____ (yes or no) _____ (organization running log)			
(8) how well bottom plugged <u>sand</u> <u>shark</u>			
DRILLERS REMARKS: <u>good</u>			

**RECEIVED**  
 SEP 18 1976

MISS. BD. OF WATER COMMISSIONERS

If well telescopes please sketch and show depths.

GROUND LEVEL

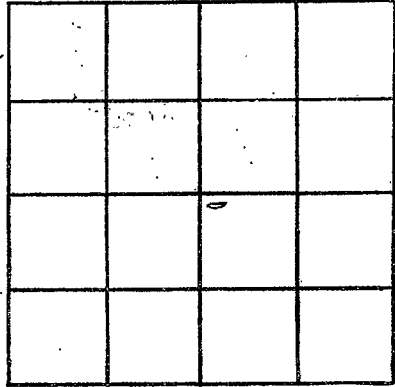

SECTION 23

Please indicate well location X.

ADDITIONAL INFORMATION

If more than one screen, show locations of each on sketch.