

**MISSISSIPPI
BOARD OF WATER COMMISSIONERS**
416 North State Street
Jackson, Mississippi 39201

WATER WELL DRILLERS LOG

WALTHALL
B 2011
8/21/76

13U

8/21 1976 Hollinger Plumb Walthall
date well completed firm name county well located


| LANDOWNER: <u>Jerry Carney</u> <u>Darburn Rd</u> | description of formations encountered | from | to |
|--|--|-----------------|------------------|
| Darburn Miss (mailing address) | Clay Sand gravel Sand pea gravel | 0 110 100 | 40 150 140 |
| WELL LOCATION: | | | |
| sec. <u>23</u> -T- <u>4</u> (N) R- <u>11</u> (E) | | | |
| <u>2</u> miles <u>N</u> of <u>Darburn</u> (distance) (direction) (nearest town) | | | |
| WELL PURPOSE: <u>Home</u> (home, irrigation, municipal, industrial) | | | |
| WELL COMPLETION DATA: | | | |
| (1) diameter (inches) <u>4"</u> | | | |
| (2) total depth (feet) <u>140</u> | | | |
| (3) static water level (feet) <u>110</u> <u>below</u> above top of ground. | | | |
| (4) casing <u>PVC</u> , <u>140</u> (material) (depth) | | | |
| _____ If telescope see back. (size) | | | |
| (5) screen <u>5</u> , <u>135</u> (length) (depth to top) | | | |
| <u>4"</u> , <u>PVC</u> (size) (material) | | | |
| (6) pump <u>3/4</u> , <u>15</u> (HP) (yield gpm) | | | |
| <u>elect.</u> (type power) | | | |
| (7) electric log _____ (yes or no) | | | |
| _____ (organization running log) | | | |
| (8) how well bottom plugged <u>sand</u> <u>shards</u> | | | |
| DRILLERS REMARKS: <u>good well</u> | | | |

RECEIVED
SEP 23 1976

MISS. BD. OF WATER COMMISSIONERS

If well telescopes please sketch and show depths.

GROUND LEVEL

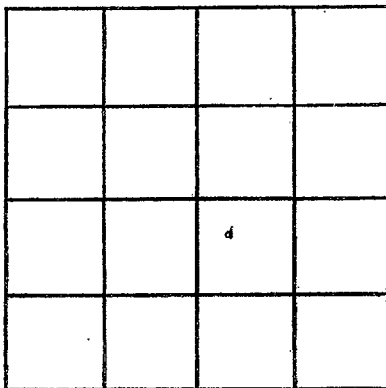

SECTION 23

Please indicate well location X.

ADDITIONAL INFORMATION

If more than one screen,
show locations of each on sketch.