

Walthall
B 2012
8/25/76

MISSISSIPPI
 BOARD OF WATER COMMISSIONERS
 416 North State Street
 Jackson, Mississippi 39201

WATER WELL DRILLERS LOG

8/25 1976 Hollinger Plumb. Walthall
 date well completed firm name county well located

LANDOWNER: Boyle Jerry
Rt 1
Darben, Miss.
 (mailing address)

| description of formations encountered | from | to |
|---------------------------------------|------------|------------|
| <u>clay sand</u> | <u>0</u> | <u>80</u> |
| <u>gravel</u> | <u>80</u> | <u>120</u> |
| <u>sand gravel</u> | <u>120</u> | <u>180</u> |

WELL LOCATION:
 sec. 12 T. 4 N. R. 11 E
S
4 miles N of Darben
 (distance) (direction) (nearest town)

WELL PURPOSE: Home
 (home, irrigation, municipal, industrial)


- WELL COMPLETION DATA:
- (1) diameter (inches) 4"
 - (2) total depth (feet) 180
 - (3) static water level (feet) 140 below above top of ground.
 - (4) casing PVC 180
 (material) (depth)
 (size) if telescope see back.
 - (5) screen 5 175
 (length) (depth to top)
4" PVC
 (size) (material)
 - (6) pump 1" 16
 (HP) (yield gpm)
elect.
 (type power)
 - (7) electric log (yes or no) _____
 (organization running log) _____
 - (8) how well bottom plugged sand
shark

DRILLERS REMARKS: good well

RECEIVED
 SEP 23 1976
 MISS. BD. OF WATER COMMISSIONERS

If well telescopes please sketch and show depths.

GROUND LEVEL

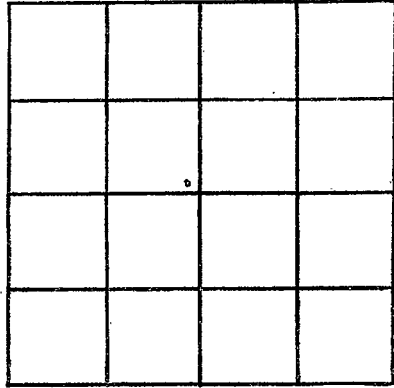

SECTION 12

Please indicate well location X.

ADDITIONAL INFORMATION

If more than one screen, show locations of each on sketch.