

WALTHALL  
 B 2014  
 10-6-76

MISSISSIPPI  
 BOARD OF WATER COMMISSIONERS  
 416 North State Street  
 Jackson, Mississippi 39201

WATER WELL DRILLERS LOG

Walthall

Oct 6 1976  
 date well completed

Reverwell Inc  
 firm name

Marion  
 county well located


LANDOWNER:	description of formations encountered	from	to
J. W. Price Rt. 1 Foxworth (mailing address)	Red clay Red sand lobbly sand & gravel	0 22 80 110	22 80 110 130
WELL LOCATION: sec. 6 T. 3 N. 4 E. R. 12 E 3 miles West of Sartoris (distance) (direction) (nearest town)			
WELL PURPOSE: home (home, irrigation, municipal, industrial)			
WELL COMPLETION DATA: (1) diameter (inches) 4" (2) total depth (feet) 130 (3) static water level (feet) 105 below top of ground. (4) casing Plastic bottom (material) (depth) (size) If telescope see back. (5) screen 6' 124 (length) (depth to top) 4" Plastic (size) (material) (6) pump 1/2 sub 10 (HP) (yield gpm) elect (type power) (7) electric log no (yes or no) (organization running log)			
(8) how well bottom plugged wooden plug DRILLERS REMARKS:			

RECEIVED  
 DEC 8 1976

MISS. RD. OF WATER COMMISSIONERS

If well telescopes please sketch and show depths.

GROUND LEVEL

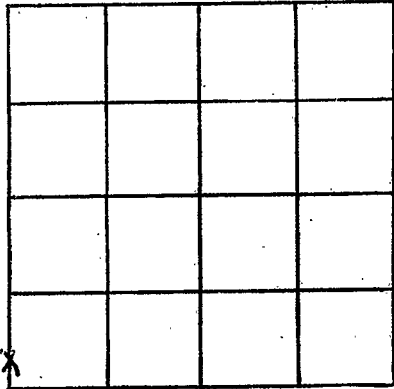

SECTION   b  

Please indicate well location X.

ADDITIONAL INFORMATION

If more than one screen,  
show locations of each on sketch.