

WALTHALL
B 2015
11-1-76

MISSISSIPPI
BOARD OF WATER COMMISSIONERS
416 North State Street
Jackson, Mississippi 39201

1374

WATER WELL DRILLERS LOG

Nov 1 1976 Recur Well Sec Walthall
date well completed firm name county well located

LANDOWNER:	description of formations encountered	from	to
Katherine Benjamin Rt 3, Jayess (mailing address)			
WELL LOCATION:			
sec 30 T 4 N R 11 E 3 miles S-SW of Sartwell (distance) (direction) (nearest town)			
WELL PURPOSE: Home (home, irrigation, municipal, industrial)			
WELL COMPLETION DATA:			
(1) diameter (inches) 4"			
(2) total depth (feet) 100			
(3) static water level (feet) 80 below top of ground.			
(4) casing plastic, bottom (material) (depth)			
(size) if telescope see back.			
(5) screen 6" 94" (length) (depth to top)			
4" plastic (size) (material)			
(6) pump by atterk (HP) (yield gpm)			
electric (type power)			
(7) electric log no (yes or no)			
(organization running log)			
(8) how well bottom plugged Wooden plug			
DRILLERS REMARKS:			


RECEIVED

FEB - 4 1977

MISS. BD. OF WATER COMMISSIONERS

If well telescopes please sketch and show depths.

GROUND LEVEL

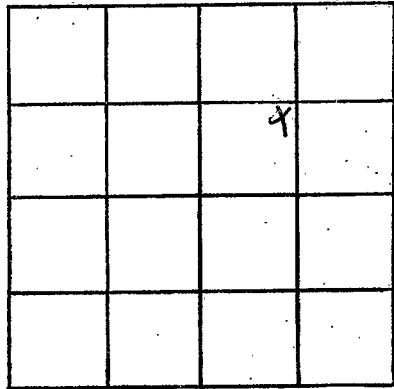

SECTION 30

Please indicate well location X.

ADDITIONAL INFORMATION

If more than one screen, show locations of each on sketch.