

WALTHALL
 B 2016
 1-20-77

MISSISSIPPI
 BOARD OF WATER COMMISSIONERS
 416 North State Street
 1381 Jackson, Mississippi 39201

②

WATER WELL DRILLERS LOG

Jan 20 1977 Acacia Well for Walthall
 date well completed firm name county well located

LANDOWNER:
Mr Simon Summers
At 1 Kahoma
 (mailing address)

description of formations encountered	from	to
Red Clay	0	10
fine sand	10	68
pink chalk	68	80
sand & pebbles	80	100

WELL LOCATION:
 sec 34 T 4 N R 11 E
2 miles S-SW of Barlow
 (distance) (direction) (nearest town)

WELL PURPOSE: Home
 (home, irrigation, municipal, industrial)

WELL COMPLETION DATA:

(1) diameter (inches) 4"

(2) total depth (feet) 100

(3) static water level (feet) 60 below top of ground.

(4) casing plastic bottom
 (material) (depth)

— If telescope see back.
 (size)

(5) screen 6" 9 ft
 (length) (depth to top)

4" plastic
 (size) (material)

(6) pump 1/2 1.0
 (HP) (yield gpm)

elect
 (type power)

(7) electric log no
 (yes or no)

—
 (organization running log)

(8) how well bottom plugged
Wooden plug


DRILLERS REMARKS:

RECEIVED
 FEB 18 1977

MISS. BD. OF W.
 MADE

If well telescopes please sketch and show depths.

GROUND LEVEL

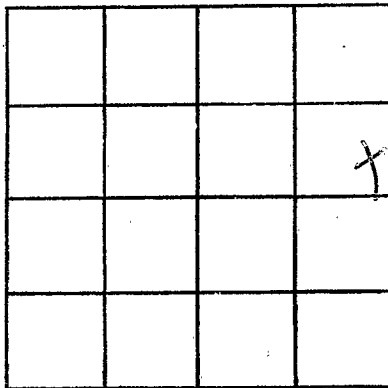

SECTION 34

Please indicate well location X.

ADDITIONAL INFORMATION

If more than one screen, show locations of each on sketch.