

WALTHALL
 B 2017
 11-18-77

MISSISSIPPI
 BOARD OF WATER COMMISSIONERS
 416 North State Street
 134 Jackson, Mississippi 39201

WATER WELL DRILLERS LOG

Nov. 18 1977 Brown well Walthall
 date well completed firm name county well located

LANDOWNER:
James P. Holmes
At. Jayess
 (mailing address)

description of formations encountered	from to	
Red Clay	0	20
Red sand	20	60
pink chalk	60	80
sand & gravel	80	100

WELL LOCATION:
 sec. 29 T 4 N R 11 E
3 1/2 miles north of Galena
 (distance) (direction) (nearest town)

WELL PURPOSE: new house
 (home, irrigation, municipal, industrial)

WELL COMPLETION DATA:

(1) diameter (inches) 4"

(2) total depth (feet) 100

(3) static water level (feet) 55 below above top of ground.

(4) casing plastic bottom
 (material) (depth)

 if telescope see back.
 (size)

(5) screen 6' bottom
 (length) (depth to top)

4" plastic
 (size) (material)

(6) pump 1/2 10
 (HP) (field gpm)

elect.
 (type power)

(7) electric log no.
 (yes or no)

 (organization running log)

(8) how well bottom plugged
wooden plug


DRILLERS REMARKS:

RECEIVED
 FEB - 7 1977

MISS. BOARD OF WATER COMMISSIONERS

If well telescopes please sketch and show depths.

GROUND LEVEL

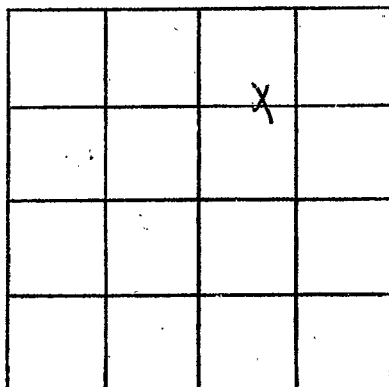

SECTION 32

Please indicate well location X.

ADDITIONAL INFORMATION

If more than one screen,
show locations of each on sketch.