

WALTHALL
B 2018
2/4/77

MISSISSIPPI
BOARD OF WATER COMMISSIONERS
416 North State Street
Jackson, Mississippi 39201

WATER WELL DRILLERS LOG

Feb. 4 1977 Brunfield Well Serv. WALTHALL
date well completed firm name county well located

LANDOWNER: Merman (Murch)
Tylertown
Miss
(mailing address)

description of formations encountered	from	to
CLAY	0	23
CHALK	23	61
SAND	61	68
SAND & Block	68	80

WELL LOCATION:
sec. 25 T. 4 N R. 11 E
11 miles N.E. of Tylertown
(distance) (direction) (nearest town)


WELL PURPOSE: CANNON
(home, irrigation, municipal, industrial)

- WELL COMPLETION DATA:
- (1) diameter (inches) 4
 - (2) total depth (feet) 80
 - (3) static water level (feet) 77 below above top of ground.
 - (4) casing Plastic 70' (material) (depth)
4" if telescope see back. (size)
 - (5) screen 10 70' (length) (depth to top)
4" Plastic (size) (material)
 - (6) pump 1/2 8 (HP) (yield gpm)
Electraic (type power)
 - (7) electric log no (yes or no)

(organization running log)

(8) how well bottom plugged Sandstone

DRILLERS REMARKS:

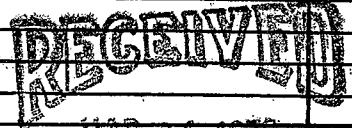


MAR 21 1978

MISS. BD. OF WATER COMMISSIONERS

If well telescopes please sketch and show depths.

GROUND LEVEL

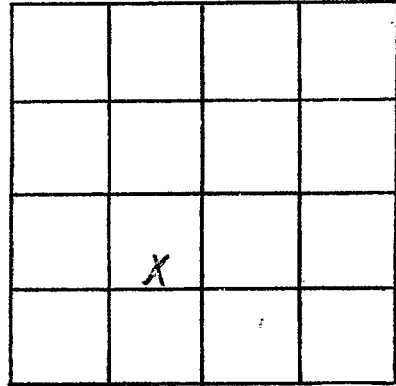

SECTION 25

Please indicate well location X.

ADDITIONAL INFORMATION

If more than one screen, show locations of each on sketch.