

WALTHALL

B 2019

3-2-77

Mar 2

date well completed

MISSISSIPPI
 BOARD OF WATER COMMISSIONERS
 416 North State Street
 Jackson, Mississippi 39201

1326 J.J. WATER WELL DRILLERS LOG Inc
 J.J. Covington

firm name

Walthall

county well located

LANDOWNER:

H/ln Cloud Helm
 Tylertown Miss
 (mailing address)

description of formations encountered

CLAY
 CLAY + SAND
 CLAY
 WATER SAND

from

to

0 19
 19 55
 55 70
 70 94

WELL LOCATION:

sec 23 T 4 N R 11 E
 11 miles NE of Tylertown
 (distance) (direction) (nearest town)

WELL PURPOSE: Home
 (home, irrigation, municipal, industrial)

WELL COMPLETION DATA:

- (1) diameter (inches) 4
- (2) total depth (feet) 94
- (3) static water level (feet) 69 below top of ground
- (4) casing Plastic 87 (material) (depth)
 (size) if telescope see back.
- (5) screen 7' 87 (length) (depth to top)
 4" Plastic (size) (material)
- (6) pump 7 (HP) (yield gpm)
 (type power)
- (7) electric log (yes or no)
 (organization running log)
- (8) how well bottom plugged Wood


RECEIVED
 APR 21 1977

DRILLERS REMARKS:

MISS. BD. OF WATER COMM

If well telescopes please sketch and show depths.

GROUND LEVEL

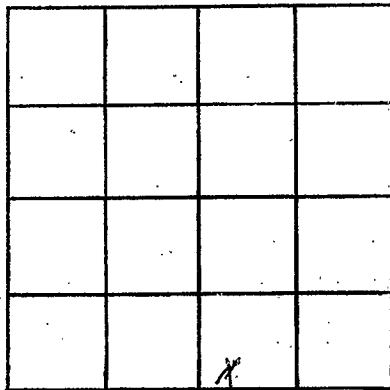

SECTION 23

Please indicate well location X.

ADDITIONAL INFORMATION

If more than one screen, show locations of each on sketch.