

WALTHALL
 B 2020
 4-11-77

MISSISSIPPI
 BOARD OF WATER COMMISSIONERS
 416 North State Street
 132A Jackson, Mississippi 39201

29

WATER WELL DRILLERS LOG

April 11 1977 Rever Well Co Walthall
 date well completed firm name county well located

LANDOWNER:
Mrs. Chara Lee Jacobs
At 3 Pop Jones
 (mailing address)

description of formations encountered	from	to
Clay	0	6
Sand	6	20
sand & gravel	20	60

WELL LOCATION:
 sec. 9 T. 4 N R. 11 E
2 miles East of Sartorisville
 (distance) (direction) (nearest town)

WELL PURPOSE: home
 (home, irrigation, municipal, industrial)

- WELL COMPLETION DATA:
- (1) diameter (inches) 4"
 - (2) total depth (feet) 60
 - (3) static water level (feet) 35 below above top of ground.
 - (4) casing plastic bottom
 (material) (depth)
 - if telescope see back.
 (size)
 - (5) screen 6" 54
 (length) (depth to top)
 - 4" plastic
 (size) (material)
 - (6) pump 1/2 sub 10
 (HP) (yield gpm)
 - split
 (type power)
 - (7) electric log no
 (yes or no)
- (organization running log)

(8) how well bottom plugged
wooden plug


DRILLERS REMARKS:

RECEIVED
 AUG 4 1977

MISS. BD. OF WATER COMMISSIONERS

If well telescopes please sketch and show depths.

GROUND LEVEL

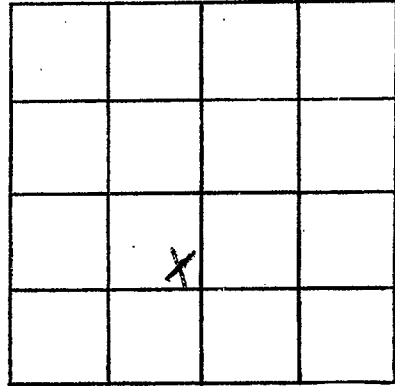

SECTION 9

Please indicate well location X.

ADDITIONAL INFORMATION

If more than one screen, show locations of each on sketch.