

WALTHALL  
B 3331  
6-10-77

MISSISSIPPI  
 BOARD OF WATER COMMISSIONERS  
 416 North State Street  
 1386 Jackson, Mississippi 39201

(62)

WATER WELL DRILLERS LOG

June 10 1977 Primmer Well Co Walthall  
 date well completed firm name county well located

LANDOWNER:  
Dick Sinn  
Rt Kekomo  
 (mailing address)

description of formations encountered	from	to
<u>Clay</u>	<u>0</u>	<u>22</u>
<u>Red sand</u>	<u>27</u>	<u>70</u>
<u>Slightly</u>	<u>70</u>	<u>95</u>
<u>sand &amp; gravel</u>	<u>95</u>	<u>100</u>
<u>Chalk</u>	<u>100</u>	<u>105</u>
<u>gravel &amp; sand</u>	<u>105</u>	<u>115</u>

WELL LOCATION:  
 sec. 26 T-4 N R-11 E  
1 miles SW-NW of Barben  
 (distance) (direction) (nearest town)

WELL PURPOSE: Trailer  
 (home, irrigation, municipal, industrial)

WELL COMPLETION DATA:

(1) diameter (inches) 4"

(2) total depth (feet) 115

(3) static water level (feet) 75 below top of ground.

(4) casing plastic (material) bottom (depth)

7 (size) if telescope see back.

(5) screen 5" (length) 110 (depth to top)

4" (size) plastic (material)

(6) pump 3/4" (HP) 12 (yield gpm)

elect (type power)

(7) electric log no (yes or no)

(organization running log)


(8) how well bottom plugged water plug

DRILLERS REMARKS:  
[Signature]

RECEIVED  
 JUN 27 1977  
 MISS. BD. OF WATER COMM

If well telescopes please  
sketch and show depths.

GROUND LEVEL

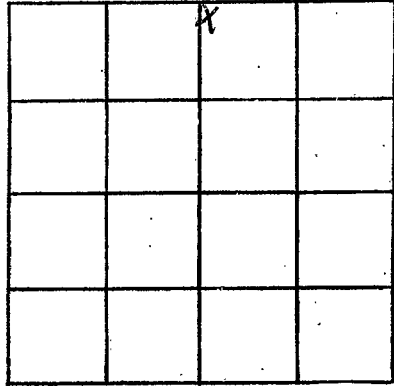

SECTION 26

Please indicate well location X.

ADDITIONAL INFORMATION

If more than one screen,  
show locations of each on sketch.