

WALTHALL
 B 3000
 6-29-77

MISSISSIPPI
 BOARD OF WATER COMMISSIONERS
 416 North State Street
 130 Jackson, Mississippi 39201

WATER WELL DRILLERS LOG

June 29 1977 Covington WALTHALL
 date well completed firm name county well located

LANDOWNER: Claude Holmes
 (Contractor)
Platform
 (mailing address)
 WELL LOCATION:
 sec. 33 T. 4N R. 11E
S W
3 1/2 miles N.E of Salem
 (distance) (direction) (nearest town)

WELL PURPOSE: Home
 (home, irrigation, municipal, industrial)

WELL COMPLETION DATA:
 (1) diameter (inches) 4"
 (2) total depth (feet) 114'
 (3) static water level (feet) 93' below top of ground.
 (4) casing Plastic, 104'
 (material) (depth)
4"
 (size) if telescope see back.
 (5) screen 10' 104'
 (length) (depth to top)
4" Plastic
 (size) (material)
 (6) pump 1/2 8
 (HP) (yield gpm)
 (type power)
 (7) electric log no
 (yes or no)
 (organization running log)
 (8) how well bottom plugged Wood


description of formations encountered	from	to
<u>CLAY</u>	<u>0</u>	<u>24</u>
<u>SANDY CLAY</u>	<u>24</u>	<u>60</u>
<u>CHALK</u>	<u>60</u>	<u>74</u>
<u>SAND</u>	<u>74</u>	<u>80</u>
<u>CHALK</u>	<u>80</u>	<u>85</u>
<u>SAND</u>	<u>85</u>	<u>114</u>

DRILLERS REMARKS:

RECEIVED
 AUG 10 1977

If well telescopes please sketch and show depths.

GROUND LEVEL

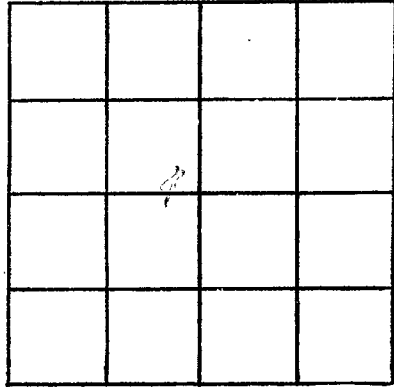

SECTION 33

Please indicate well location X.

ADDITIONAL INFORMATION

If more than one screen, show locations of each on sketch.