

Walthall
B 2053
7/27/77

MISSISSIPPI
BOARD OF WATER COMMISSIONERS
416 North State Street
Jackson, Mississippi 39201

(93)

WATER WELL DRILLERS LOG

July 27 1977 Revere Miller Walthall
date well completed firm name county well located

LANDOWNER:
Ted Barzoman
Rt 3 Jagers
(mailing address)

WELL LOCATION:
sec. 10 T-4 N R-11 E
3 miles east of Scottsville
(distance) (direction) (nearest town)

WELL PURPOSE: Dairy Farm
(home, irrigation, municipal, industrial)

WELL COMPLETION DATA:
(1) diameter (inches) 4"
(2) total depth (feet) 146
(3) static water level (feet) 99 below top of ground
(4) casing plastic, bottom
(material) (depth)
if telescope see back.
(size)
(5) screen 10' length, 136 depth to top
4" plastic
(size) (material)
(6) pump 1 Sub 20
(HP) (yield gpm)
elect
(type power)
(7) electric log no
(yes or no)
(organization running log)

(8) how well bottom plugged
Woodsman

DRILLERS REMARKS:


description of formations encountered	from	to
red clay	0	18
red sand	18	70
sand + gravel	70	92
lumpy sand	92	130
coarse sand & pebbles	130	146

RECEIVED
DEC 29 1977

MISS. BD. OF WATER COMM

If well telescopes please sketch and show depths.

GROUND LEVEL

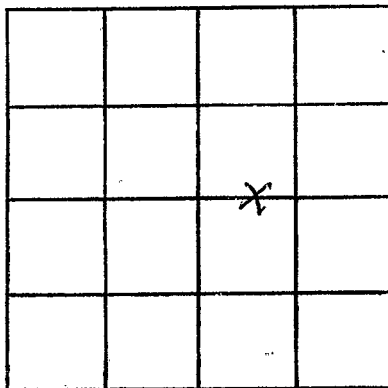

SECTION 10

Please indicate well location X.

ADDITIONAL INFORMATION

If more than one screen, show locations of each on sketch.