

Walthall  
B 2004  
8/3/77

MISSISSIPPI  
BOARD OF WATER COMMISSIONERS  
416 North State Street  
Jackson, Mississippi 39201

97

WATER WELL DRILLERS LOG

Aug 3 - 1977 Reem Miller Walthall  
date well completed firm name county well located

LANDOWNER:  
J. P. Bayles  
Rt 3 Jayess  
(mailing address)

description of formations encountered	from	to
Clay	0	17
Red sand	17	25
lumpy sand	25	27
gravel sand	27	110

WELL LOCATION:  
sec. 4 T 4 N R 11 E  
3 miles N-NE of Sartonville  
(distance) (direction) (nearest town)

WELL PURPOSE: private  
(home, irrigation, municipal, industrial)

- WELL COMPLETION DATA:
- (1) diameter (inches) 4"
  - (2) total depth (feet) 110
  - (3) static water level (feet) 77 below above top of ground
  - (4) casing plastic bottom  
(material) (depth)
  - if telescope see back.  
(size)
  - (5) screen 5' 105'  
(length) (depth to top)
  - 4" plastic  
(size) (material)
  - (6) pump 5 sub 1.0  
(HP) (yield gpm)
  - 2 hp  
(type power)
  - (7) electric log no  
(yes or no)
  - (organization running log)

(8) how well bottom plugged  
wooden plug


DRILLERS REMARKS:

RECEIVED  
DEC 30 1977

MISS. BD. OF WATER

If well telescopes please sketch and show depths.

GROUND LEVEL

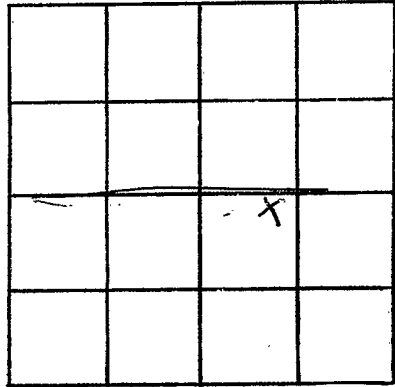

SECTION 4

Please indicate well location X.

ADDITIONAL INFORMATION

Lined area for additional information.

If more than one screen, show locations of each on sketch.