

WALTHALL

B

3-6-78

MISSISSIPPI BOARD OF WATER COMMISSIONERS 416 North State Street Jackson, Mississippi 39201

WATER WELL DRILLERS LOG

March 6 1978 date well completed

Reynolds Walthall firm name

Walthall county well located

LANDOWNER:

C. C. Sawyer

At: Jackson (mailing address)

WELL LOCATION:

sec. 29 T. 4 N R. 11 E 3 S 3 miles South of Scottsville (distance) (direction) (nearest town)

WELL PURPOSE: house (home, irrigation, municipal, industrial)

WELL COMPLETION DATA:

- (1) diameter (inches) 4"
(2) total depth (feet) 100
(3) static water level (feet) 5 below top of ground.
(4) casing Plastic, bottom (material) (depth)
(5) screen 5' 95' (length) (depth to top)
(6) pump 1/2 HP 10 (HP) (yield gpm)
(7) electric log no (yes or no)
(organization running log)

(8) how well bottom plugged: Wooden plug

DRILLERS REMARKS:

description of formations encountered

from to

sandy clay 0 20
sand & gravel 20 60
Chalky sand 60 80
fine gravel & sand 80 100


RECEIVED

MAY 11 1978

MISS. BD. OF WATER COMMISSIONERS

If well telescopes please sketch and show depths.

GROUND LEVEL

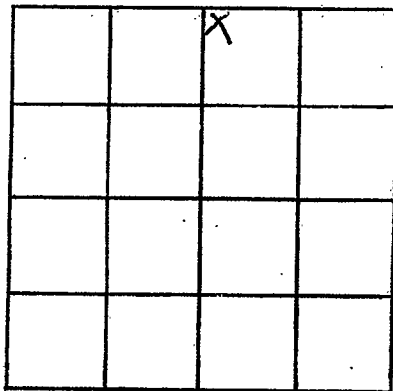

SECTION 29

Please indicate well location X.

ADDITIONAL INFORMATION

If more than one screen,
show locations of each on sketch.