

WALTHALL
B 2057
5-12-78

MISSISSIPPI
 BOARD OF WATER COMMISSIONERS
 416 North State Street
 Jackson, Mississippi 39201

WATER WELL DRILLERS LOG

May 13 1978 Reeves Miller Walthall
 date well completed firm name county well located


LANDOWNER:	description of formations encountered	from	to
T (Buck) Beard Bt Jays (mailing address)	Red clay Red cherty sand small gravel sand	0	22 103 175
WELL LOCATION: sec <u>6</u> T <u>4</u> N R <u>11</u> E <u>1</u> miles <u>N-NE</u> of <u>SATTIN WALKER</u> (distance) (direction) (nearest town)			
WELL PURPOSE: <u>new house</u> (home, irrigation, municipal, industrial)			
WELL COMPLETION DATA:			
(1) diameter (inches) <u>4"</u>			
(2) total depth (feet) <u>113</u>			
(3) static water level (feet) <u>80</u> below top of ground.			
(4) casing <u>plastic, bottom</u> (material) (depth)			
<input checked="" type="checkbox"/> if telescope see back. (size)			
(5) screen <u>5'</u> , <u>113'</u> (length) (depth to top)			
<u>4"</u> , <u>plastic</u> (size) (material)			
(6) pump <u>1/2 hp.</u> , <u>10</u> (HP) (yield gpm)			
<u>split</u> (type power)			
(7) electric log <u>no</u> (yes or no)			
(organization running log)			
(8) how well bottom plugged <u>water plug</u>			
DRILLERS REMARKS: <u>no remarks -</u>			

RECEIVED

AUG 28 1978

If well telescopes please sketch and show depths.

GROUND LEVEL

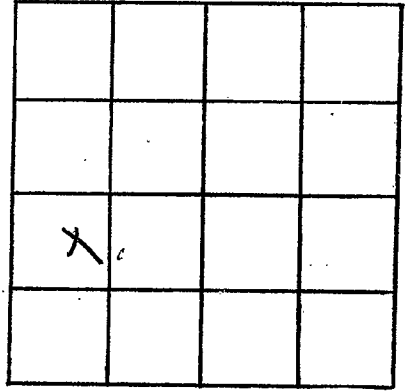

SECTION b

Please indicate well location X.

ADDITIONAL INFORMATION

If more than one screen,
show locations of each on sketch.