

BOARD OF WATER COMMISSIONERS
416 North State Street
Jackson, Mississippi 39201

Walthall
B 2017
3-26-79

WATER WELL DRILLERS LOG

March 26 1979 Reena Miller Walthall
date well completed firm name county well located

LANDOWNER:
Kenneth Hebert
Rt Jayess
(mailing address)

description of formations encountered	from	to
<u>clay</u>	<u>0</u>	<u>5</u>
<u>chalk</u>	<u>5</u>	<u>60</u>
<u>old sand</u>	<u>60</u>	<u>80</u>
<u>lumpy sand</u>	<u>80</u>	<u>103</u>
<u>small gravel</u>	<u>103</u>	<u>118</u>

WELL LOCATION:
sec. 7 T. 4 N. R. 11 E
1 miles West of Sartorisville
(distance) (direction) (nearest town)

WELL PURPOSE: home
(home, irrigation, municipal, industrial)

WELL COMPLETION DATA:
(1) diameter (inches) 4"
(2) total depth (feet) 118
(3) static water level (feet) 85 below top of ground.
(4) casing plastic bottom
(material) (depth)
5' if telescope see back.
(size)
(5) screen 5' 113'
(length) (depth to top)
4" plastic
(size) (material)
(6) pump 1/2 10
(HP) (yield gpm)
elect
(type power)
(7) electric log no
(yes or no)
(organization running log)

(8) how well bottom plugged
wooden plug

DRILLERS REMARKS:
[Signature]


Miss. Board of Water Comm.

JUN 18 1979

RECEIVED

If well telescopes please sketch and show depths.

GROUND LEVEL

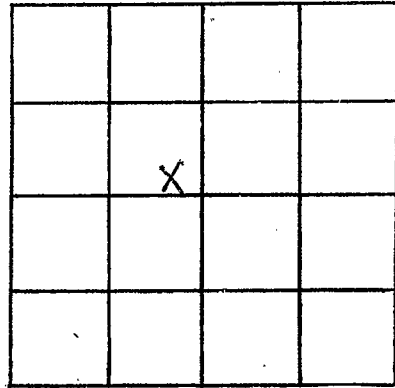

SECTION 7

Please indicate well location X.

ADDITIONAL INFORMATION

If more than one screen,
show locations of each on sketch.